


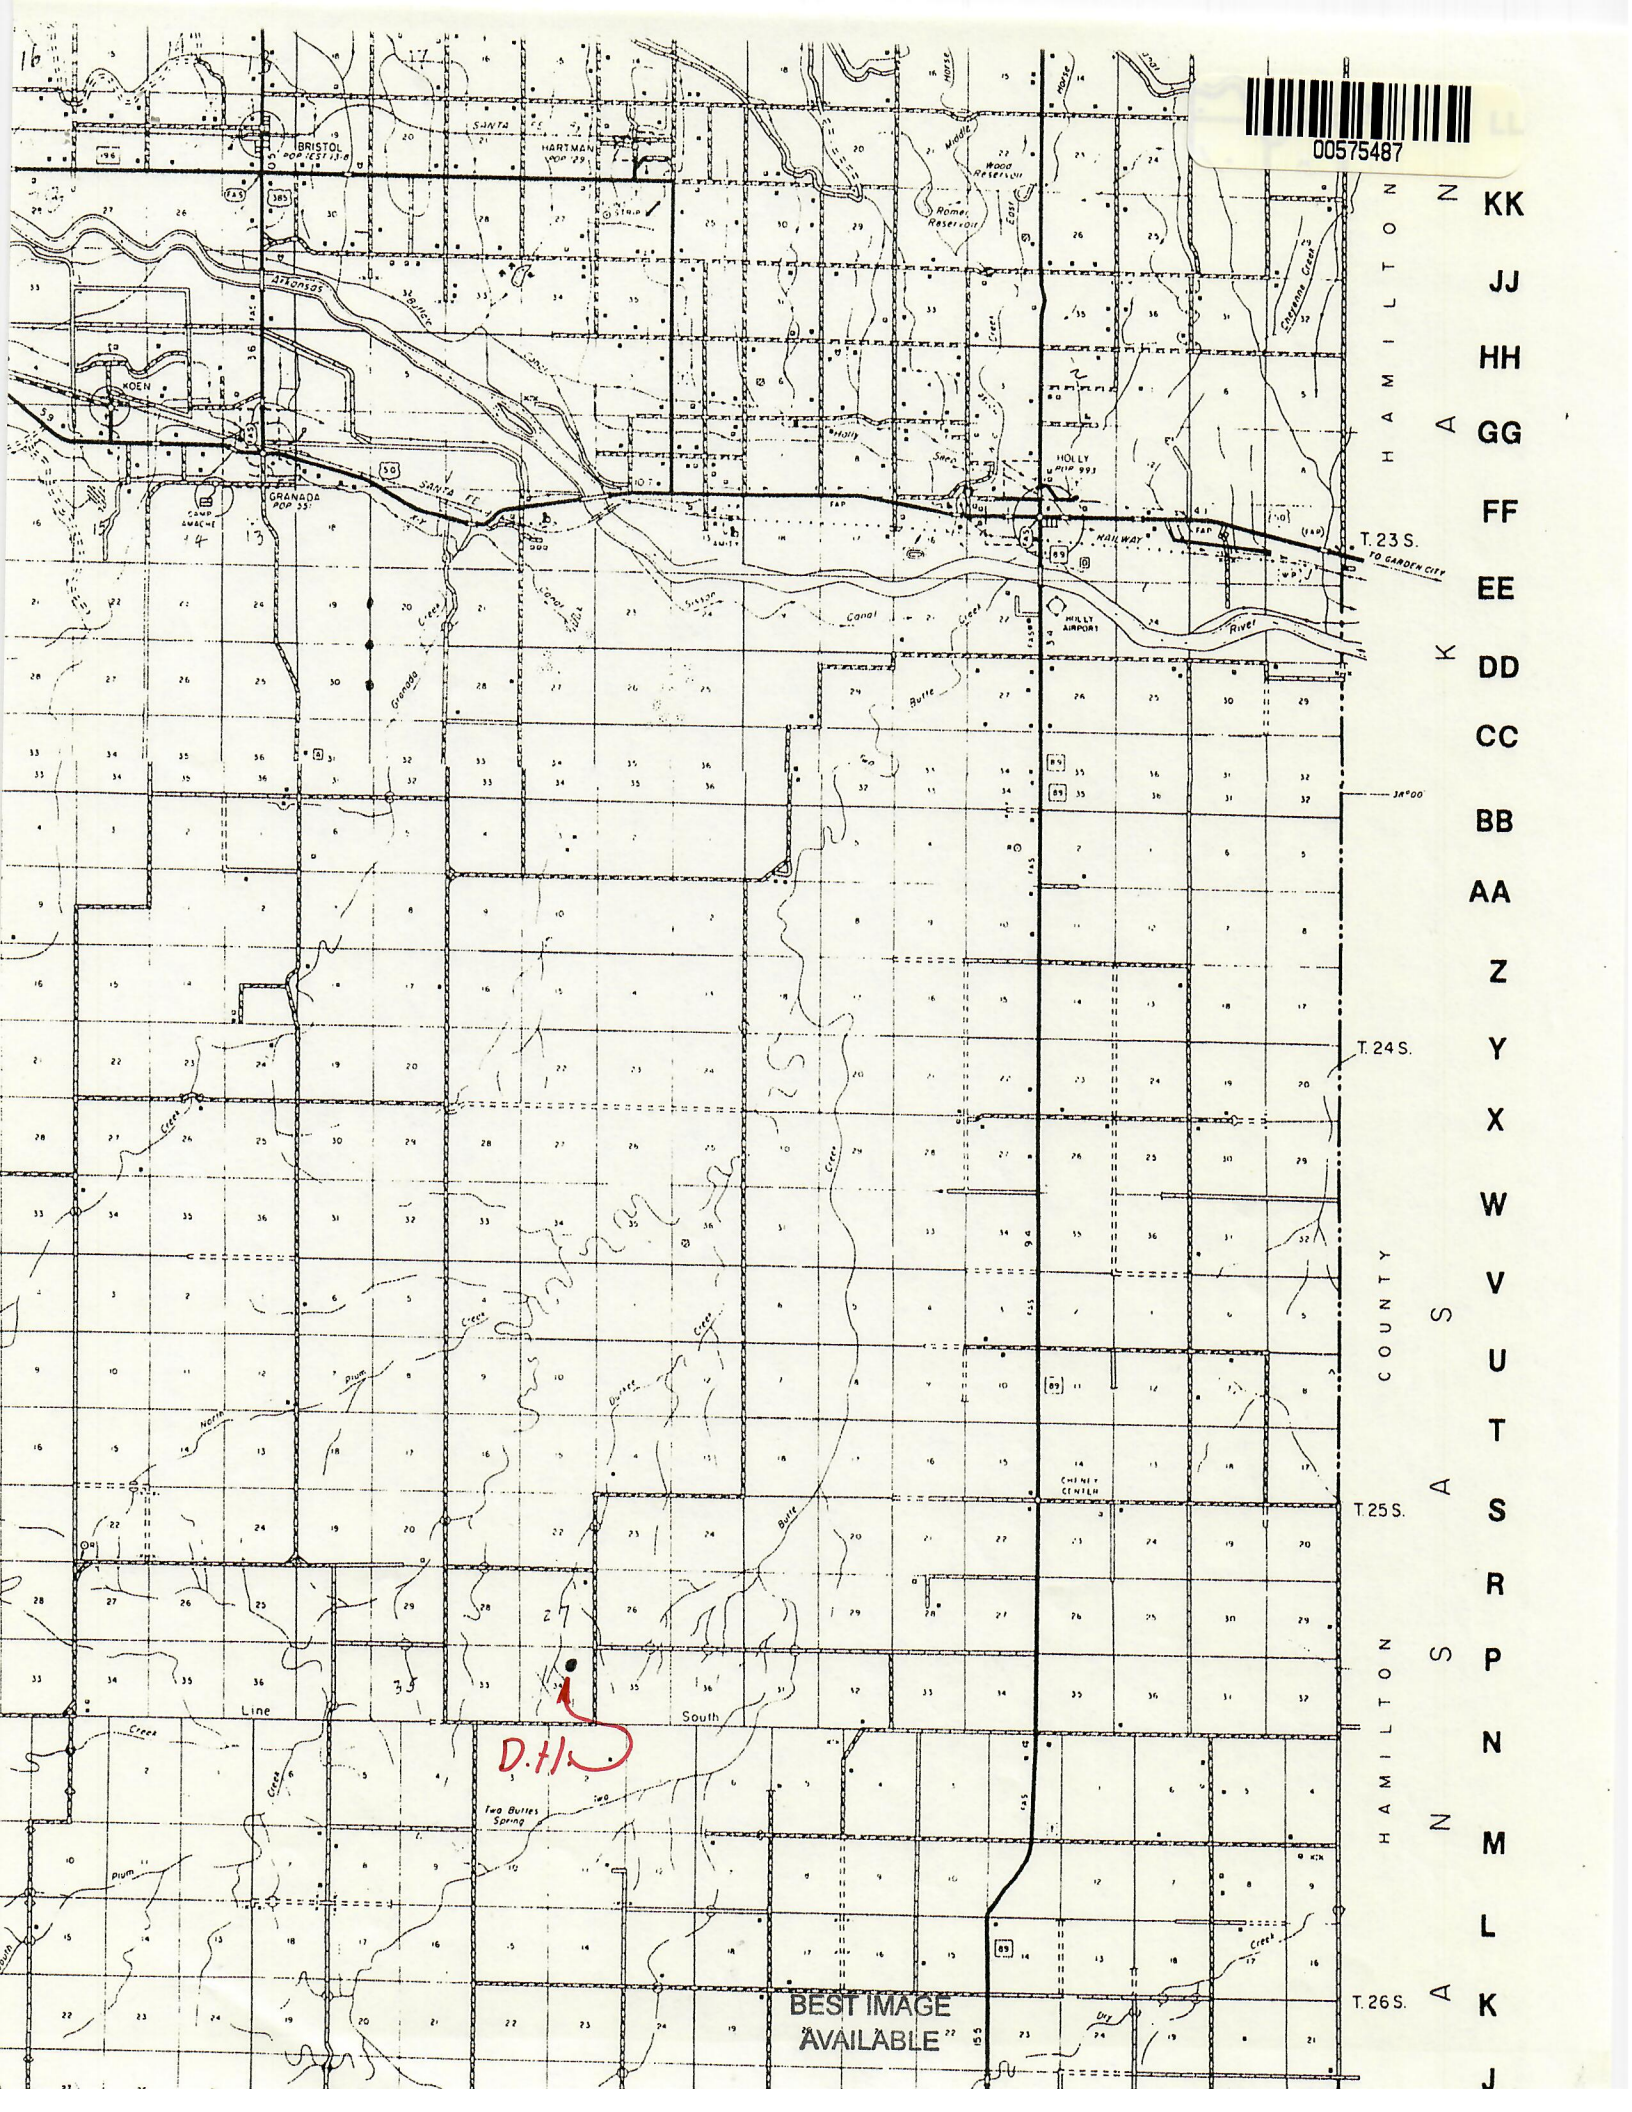

00575487



N  
K K  
J J  
H H  
A G  
F F  
E E  
K D  
C C  
B B  
A A  
Z  
Y  
X  
W  
V  
U  
T  
S  
R  
P  
N  
M  
L  
A K  
J

BEST IMAGE  
AVAILABLE