


CERTIFICATE OF SURVEY  
Logan County, Colorado  
for  
Ryan Oil Co.




T12N R53W 6P.M.

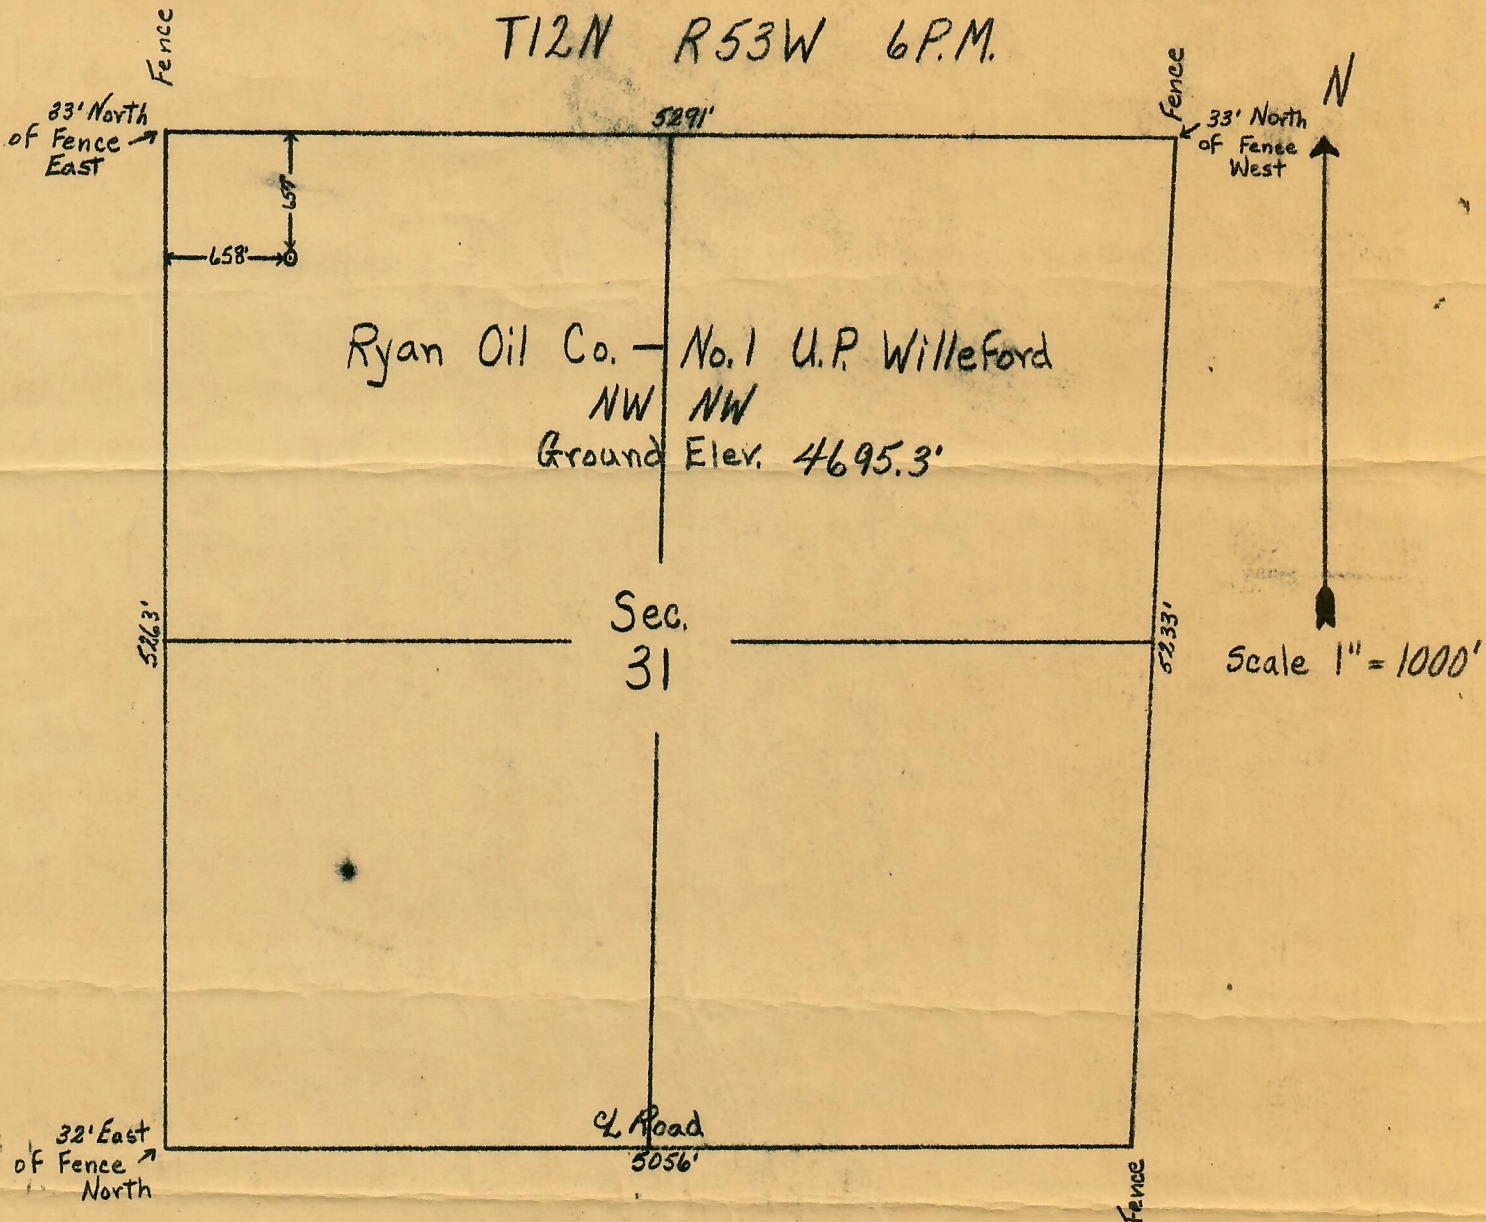

I hereby certify that the above plat is an accurate representation of a correct survey showing the location of Ryan Oil Co. - U.P. Willeford No. 1 Oilwell in the C ~~XXXXXX~~ NW NW Sec. 31 T12 N R53W 6P.M. The elevation of the ground at the stake is 4695.3 feet above sea level from U.S.G.S. Bench Mark.

Fort Morgan, Colorado  
April 2, 1955

Registered Professional Engineer  
State of Colorado

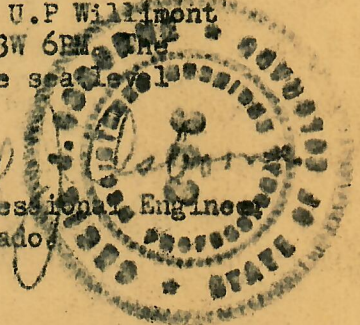

L-15

5600

3