

OIL AND GAS CONSERVATION COMMISSION  
OF THE STATE OF COLORADO

RECEIVED  
JUL 21 1960  
OIL & GAS  
CONSERVATION COMMISSION

NOTICE OF INTENTION TO DRILL


INSTRUCTIONS:

A notice of intention to drill a well shall be filed in duplicate on all Federal and Patented lands, and in triplicate on all State lands. Do not begin operations until approved copy has been received. It is mandatory that the proposed location comply with all rules and regulations of the Commission. Locate well on section grid in proper location, and indicate extent of lease. Unless operations are commenced within 180 days after the date of approval hereof, this approval to drill will become null and void.

Name of Operator Cabeen Exploration Corporation Phone No. AMherst 6-1635  
Address 945 Petroleum Club Bldg. City Denver 2, State Colorado

How is liability secured: Well Bond (Attached) ; Blanket Bond ; Waiver   
(Check one)

Lease Name Laura M. Jensen  
Well No. 1  
Field Name Wildcat   
County Logan

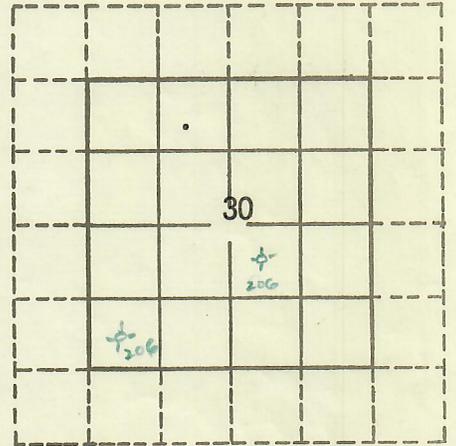

Location NE NW (quarter quarter) Section 30 Township 12N Range 53W Meridian 6th  
660 feet from N Section line and 1980 feet from W Section Line  
N or S E or W

The well is located on: Patented land  State land  Federal land   
The well is located within a spaced area: Yes  No

Distance from proposed location to nearest property or lease line 660 feet.  
Distance from proposed location to nearest drilling unit line \_\_\_\_\_ feet.

Objectives: Dakota "D" Depth 5420 ; Dakota "J" Depth 5530  
Formation Estimate Formation Estimate

Proposed length of surface casing 200 + - feet.

REMARKS:

Agent	<u>OK</u>
Bond	<u>attached</u>
Spot	<input checked="" type="checkbox"/>
800 ft.	<input type="checkbox"/>
1200 ft.	<input type="checkbox"/>
Wells	<input type="checkbox"/>
Oil	<input type="checkbox"/>
Gas	<input type="checkbox"/>
Status	<input type="checkbox"/>

*Correction 9/19/60*  
OGCC 6

I/We hereby swear (or affirm) that the statements herein made are a full and correct report.

APPROVED:

Date July 21 1960

Director

Company Cabeen Exploration Corp. Date July 19, 1960  
945 Petroleum Club Bldg. AMherst  
Address Denver 2, Colorado Phone No. 6-1635

By [Signature] Title Dist. Drlg. & Prod. Mgr.  
Signature