


6N-64W-2

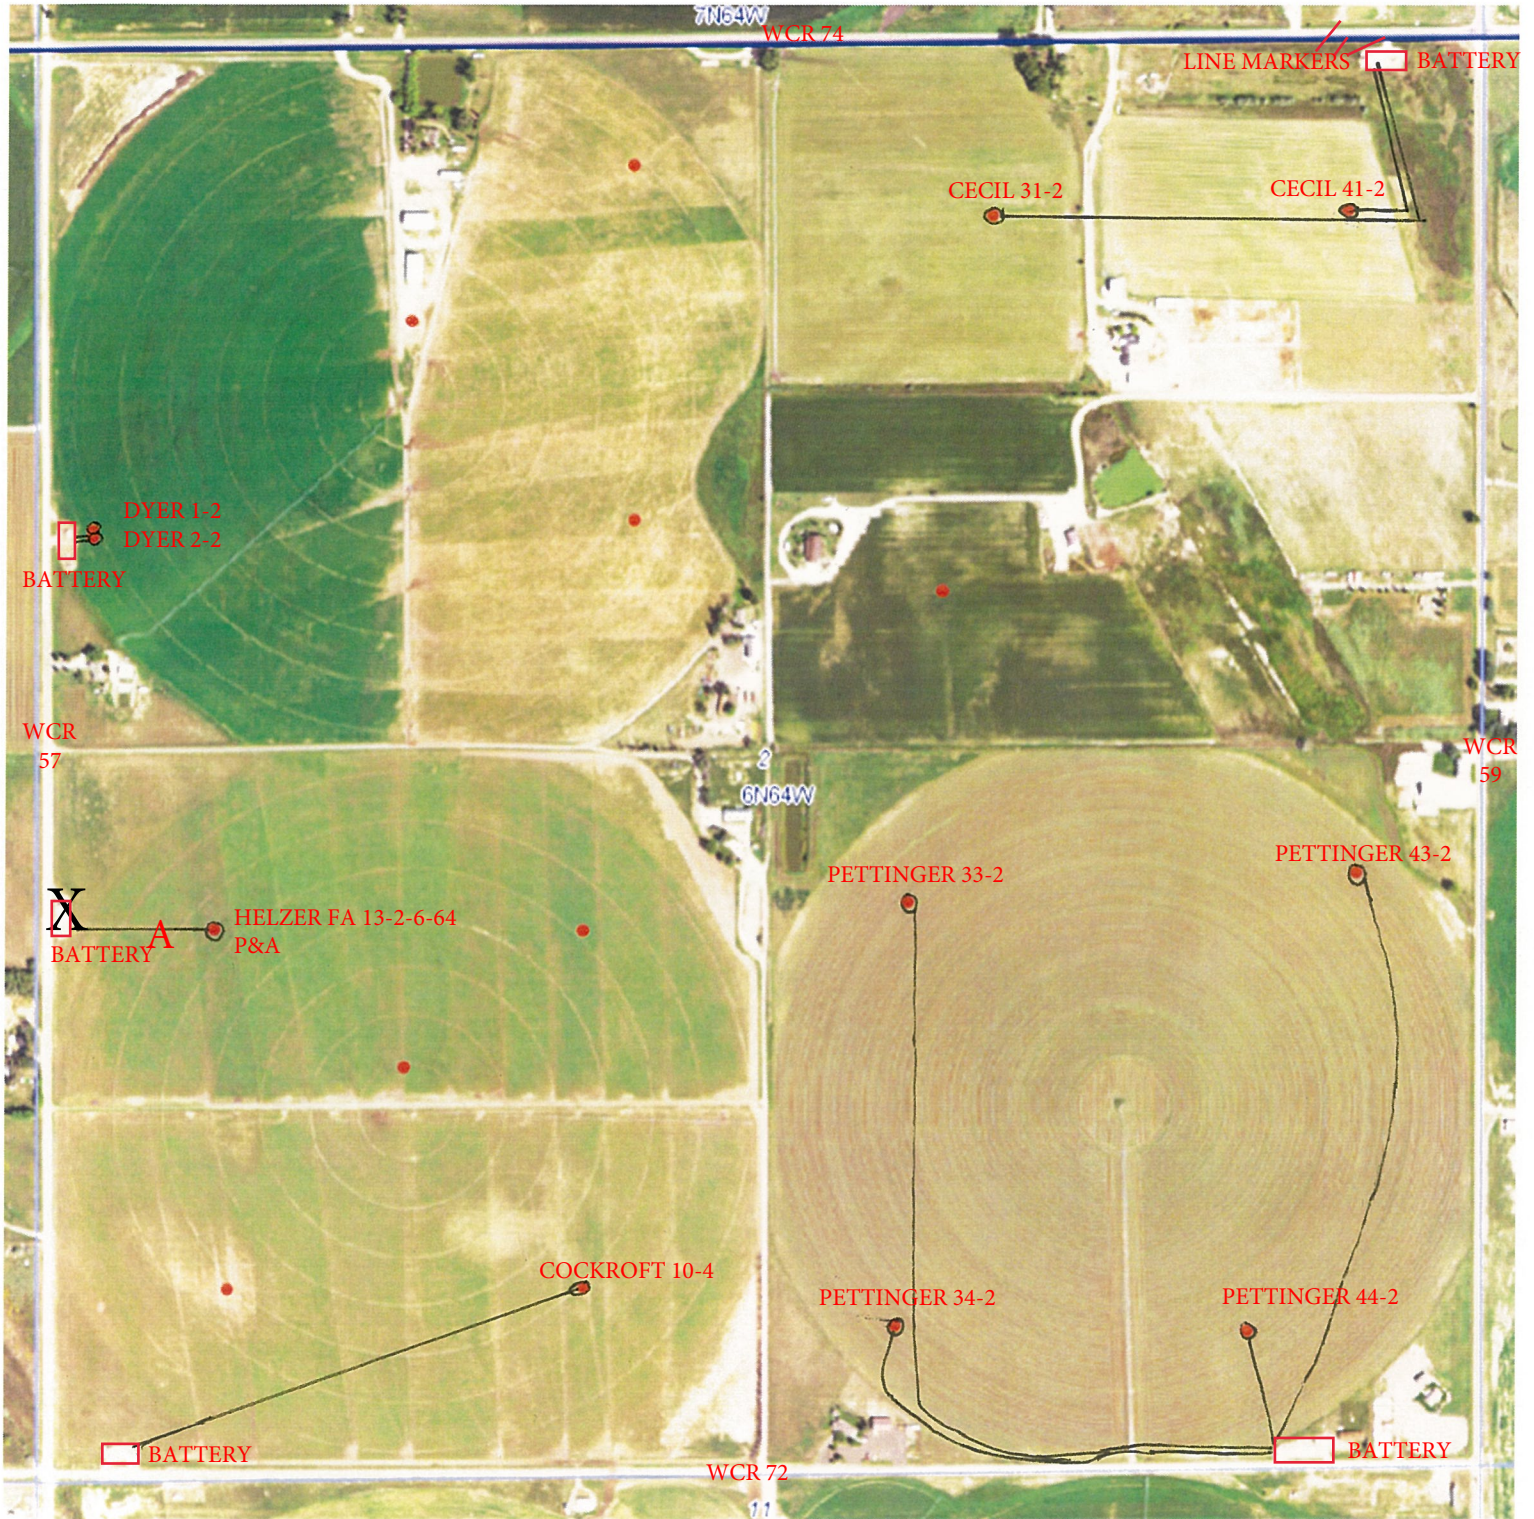

HELZER FA 13-2-6-24 P&A 10/18 ABANDONED F/L