




RECEIVED
FEB -1 1966

OIL & GAS
CONSERVATION COMMISSION

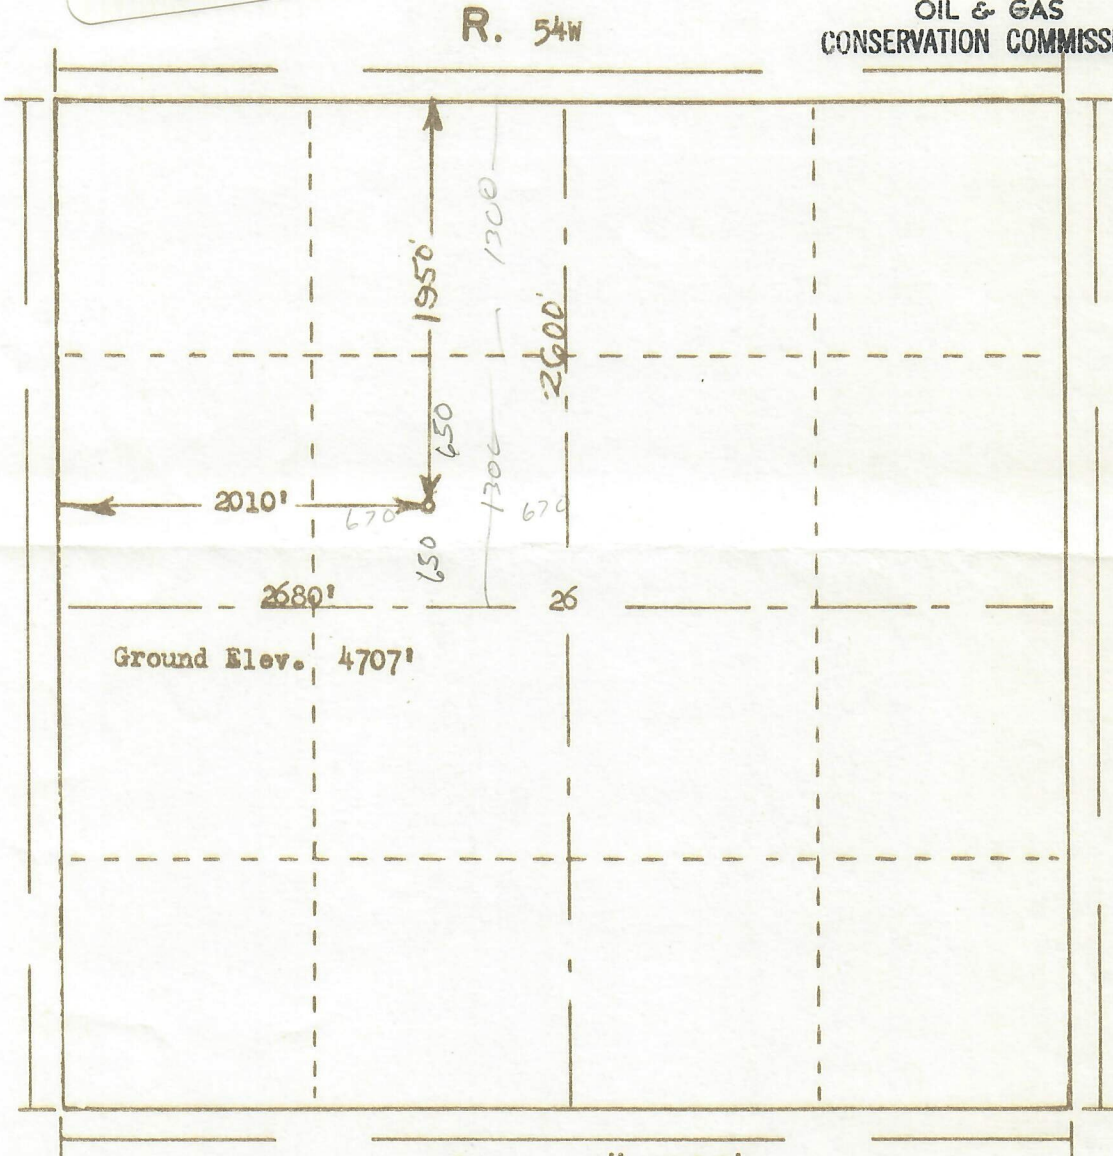

Scale ... 1" = 1000'

Powers Surveyors, Inc. of Denver, Colorado
has in accordance with a request from Florence Johnston
for Stuarco Oil Co., Inc. determined the
Location of No. 1 Ayres
to be OSE NW Section 26 Township 12N
Range 54W of the 6th Principal Meridian
Logan County, Colorado

I hereby certify that this plat is an
accurate representation of a correct
survey showing the location of

Date: 1-27-66

Billy G. Holloway
Licensed Land Surveyor No. 2853
State of Colorado

66-37

2680
-2010
670

670
670
1340
1340
2680

2680
1300
650