


Inspection Photos
Operator Name: D & G Roustabout Service
Location ID: 323827



D & G sales meter building

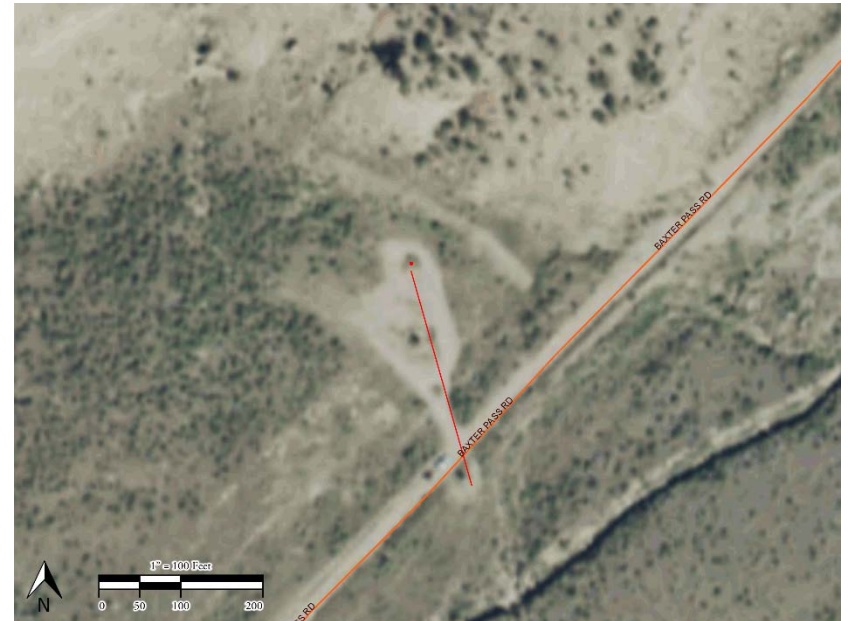

**Flowline travels 270' south and
under Baxter Pass Road**