


Waulco Resources LLC
Final Wellbore Diagram

2-2-20 Cmp.

Cement Surface Plug.
20' of casing cut off
w/ steel plate welded
on top of casing stub
and well information
put on steel plate -

527' of 8 5/8" 24#/ft
J-55 STC casing run
on 8-25-19. Minimum
surface casing setting
depth was set at 500'. Casing
was cemented back to surface
w/ 160 sxs of A Serv Lite &
150 sxs of Premium Plus.
Full cement returns
throughout cement job
and got 20 bbls cement
back to surface.

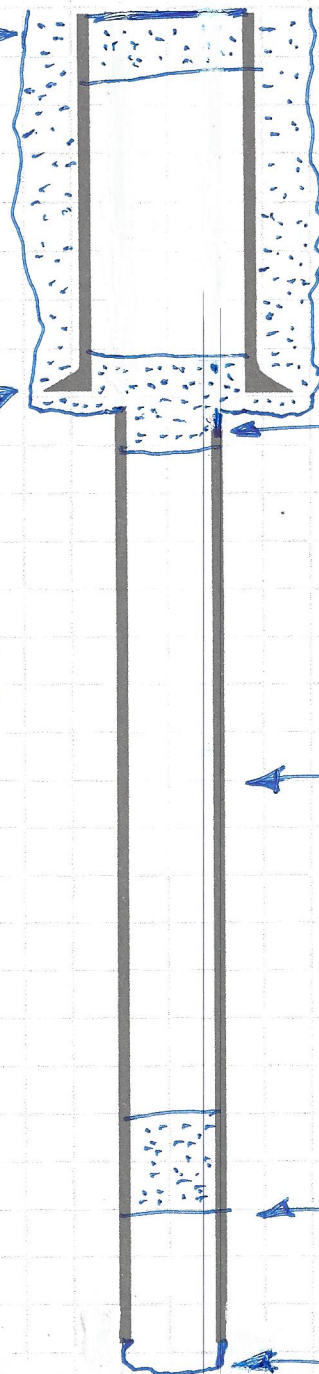

LEASE & WELL NO. Millican #1-7
FORMATION Dry Hole
COUNTY & STATE Baca County, CO

12 1/4" hole to 557' (drillers depth)
or 547' pipe depth w/ 20'
cut off at surface to GL.

Cmt plug 50' above and below
casing shoe.

7 7/8" hole

5740' (top of Morrison Formation)

TD 6857'

Plugged well as Dry Hole on 9-4-19
as per COGCC's recommendation.

Plug #1 - 40 sacks Class C from top
of Morrison @ 5740'. Cmt 5640' - 5740'

Plug #2 - 50 sacks Class C across csg
shoe. Cmt 477' - 577' (actual depths)

Plug #3 - 15 sacks @ surface