



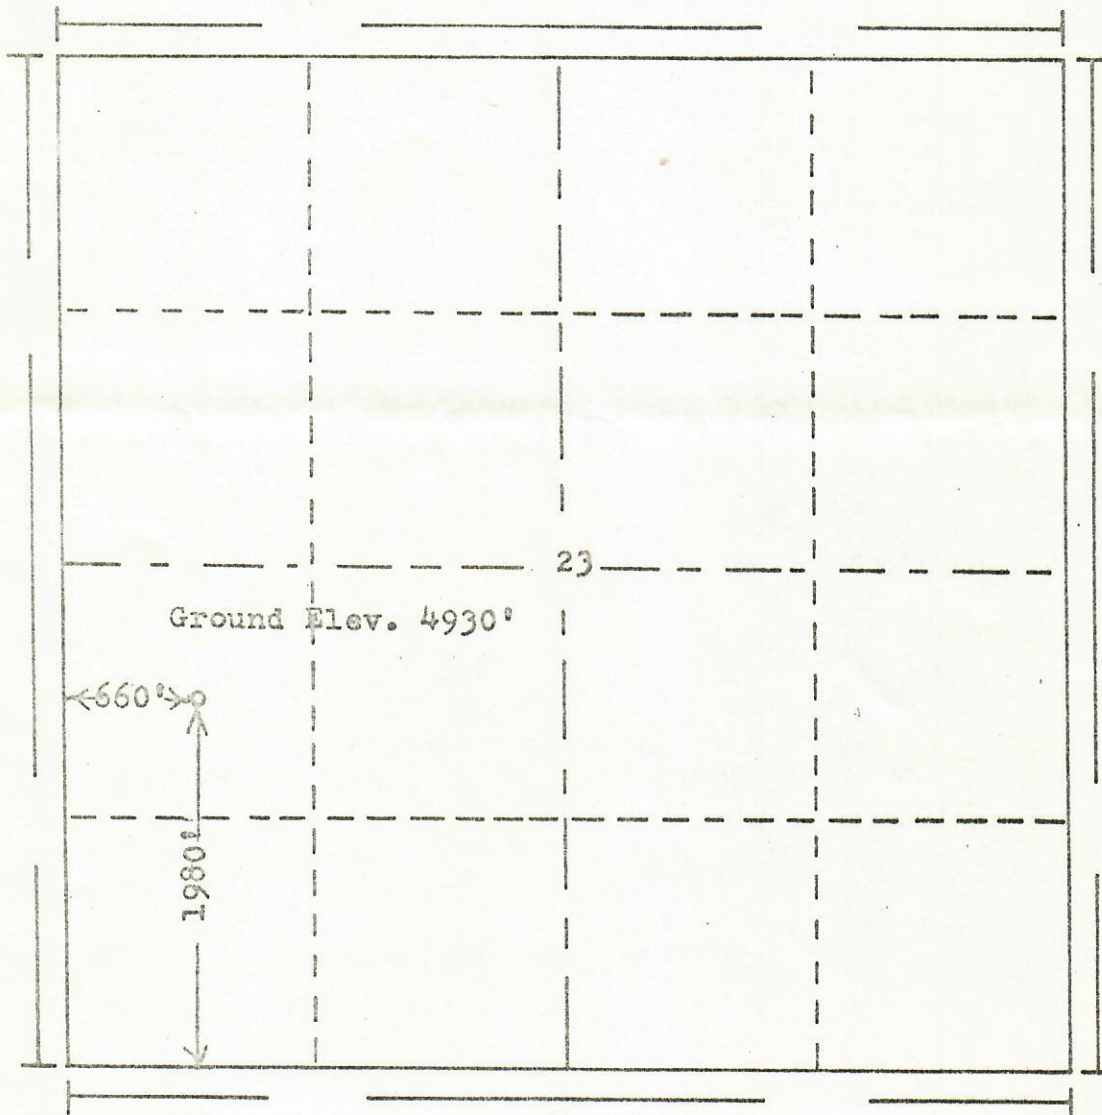
00283999

RECEIVED

OCT 2 1968

COLO. OIL &amp; GAS CONS. COMM.

R. 56W

T.  
12  
N

Scale... 1" = 1000'

Powers Elevation Company, Inc. of Denver, Colorado  
has in accordance with a request from Mr. Gasch  
for Chancellor Exploration Co.

determined the location of No. 1 Ducekowsky;  
to be CNW SW Section 23 Township 12N  
Range 56W of the 6th Principal Meridian  
Weld County, Colorado

I hereby certify that this plat is an  
accurate representation of a correct  
survey showing the location of

Date: 9-20-68

*Billy G. Zolner*  
Licensed Land Surveyor No. 2853  
State of Colorado

DVR	
FJP	
HHM	
JAM	✓
JJD	✓