

OIL AND GAS CONSERVATION COMMISSION OF THE STATE OF COLORADO



NOTICE OF INTENTION TO DRILL




INSTRUCTIONS:

A notice of intention to drill a well shall be filed in duplicate on all Federal and Patented lands, and in triplicate on all State lands. Do not begin operations until approved copy has been received. It is mandatory that the proposed location of lease. Unless operations are commenced within 180 days after the date of approval hereof, this approval to drill will become null and void.

Name of Operator UTAH SOUTHERN OIL COMPANY ⁹¹⁹⁷⁵ Phone No. EM 4-5669
Address 901 Utah Oil Building City Salt Lake City State Utah

How is liability secured: Well Bond (Attached) ☐; Blanket Bond ☒; Waiver ☐ on file
(Check one)

Lease Name Schroeder
Well No. #2
Field Name May Wildcat ☐
County Weld

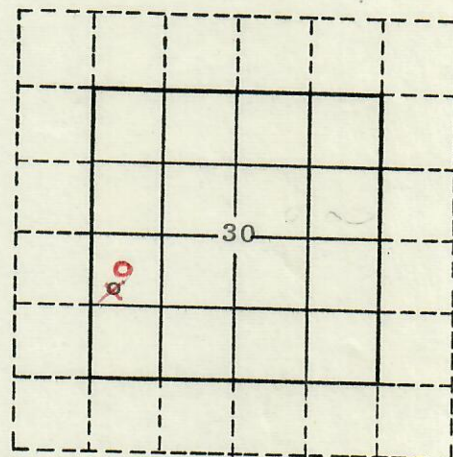

Location NW SW 30 (quarter quarter) Section 30 Township 12N Range 56W Meridian 6th PM
3300 feet from N Section line and 660 feet from W Section Line
2600 660 N or S E or W

The well is located on: Patented land ☒ State land ☐ Federal land ☐

The well is located within a spaced area: Yes ☐ No ☒

Distance from proposed location to nearest property or lease line 660 feet.
Distance from proposed location to nearest drilling unit line - feet.

Objectives: "D" Sand Depth 6300 ; "J" Sand Depth 6400
Formation Estimate Formation Estimate

Proposed length of surface casing 300' feet. of 8-5/8"

REMARKS:

Agent	<u>600 ft.</u>
Bond	<u>1000 ft.</u>
Spot	<u>Wells</u>
600 ft.	<u>Oil</u>
1000 ft.	<u>Gas</u>
Wells	<u>Status</u>
Oil	
Gas	
Status	

I/We hereby swear (or affirm) that the statements herein made are a full and correct report.

APPROVED:

Date NOV - 6 1957

Company UTAH SOUTHERN OIL CO. Date Nov. 4, 1957

Address 901 Utah Oil Bldg. Phone No. EM 4-5669

By George T. Hignature, Jr. Title Vice President

Director