

Foundation Energy Management, LLC

WELLBORE DIAGRAM

Well / Battery	Prospect Name	Total Depth	Current Status
Schmidt 1-2			
Location	Sec-Twn-Rng	Producing Horizon	County & State

WELLBORE DIAGRAM

Prepared Date: 1-3-2020
Prepared By: Mike Bohler

General Info

API #: 05-125-06104

KB Elevation:

GL Elevation:


Spud Date:

Completion Date:

TVD:

MD:

Last PBDT:

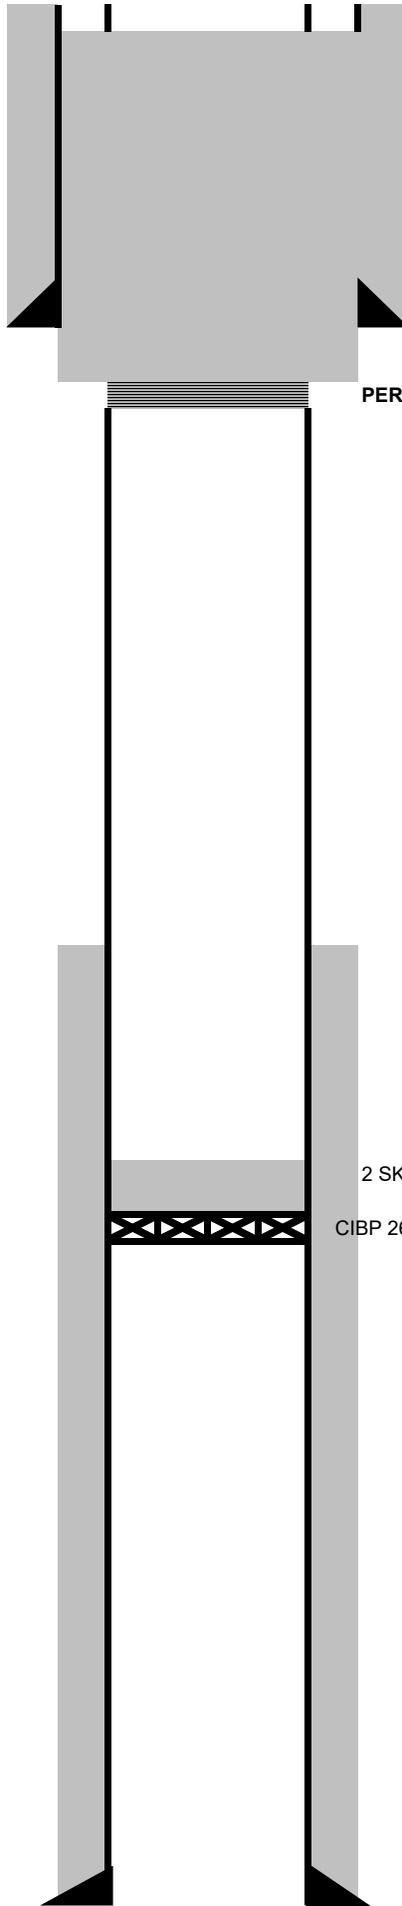

CONDUCTOR CSG

PUMPED 130SKS TO SURFACE

Surface Casing

8 5/8 inch (OD)
 24 # (weight)
 \ grade
 374 depth from KB
 0 cement top Visual Returns
 370 sacks of cement
 12 1/4 inch (OD) HOLE SIZE

Production Casing

4.5 inch (OD)
 9.5 # (weight)
 grade
 2765 depth from KB
 2040 cement top
 150 sacks of cement
 7 7/8 inch (OD) HOLE SIZE

Calculated

Open Perforations

PBDT

TD=