


# OIL AND GAS CONSERVATION COMMISSION OF THE STATE OF COLORADO

## NOTICE OF INTENTION TO DRILL

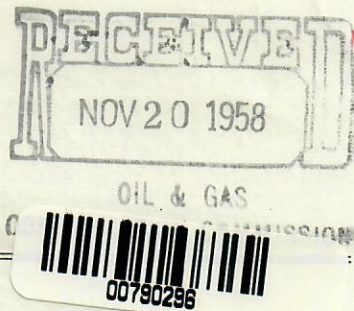


### INSTRUCTIONS:

A notice of intention to drill a well shall be filed in duplicate on all Federal and Patented lands, and in triplicate on all State lands. Do not begin operations until approved copy has been received. It is mandatory that the proposed location comply with all rules and regulations of the Commission. Locate well on section grid in proper location, and indicate extent of lease. Unless operations are commenced within 180 days after the date of approval hereof, this approval to drill will become null and void.

Name of Operator UTAH SOUTHERN OIL COMPANY Phone No. AM 6 3173  
Address 1825 First National Bank Bldg. City Denver, State Colorado

How is liability secured: Well Bond (Attached) ☐; Blanket Bond ☒; Waiver ☐ on file  
(Check one)

Lease Name Schroeder  
Well No. 3  
Field Name May Wildcat ☐  
County Weld

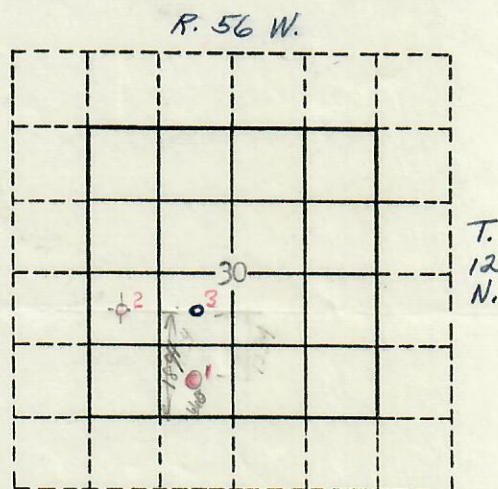

Location NE SW Section 30 Township 12 N Range 56 W Meridian 6th P.M.  
(quarter quarter)  
1894 feet from South Section line and 1925 feet from West Section Line  
N or S E or W

The well is located on: Patented land ☒ State land ☐ Federal land ☐

The well is located within a spaced area: Yes ☐ No ☒

Distance from proposed location to nearest property or lease line 660 feet.

Distance from proposed location to nearest drilling unit line \_\_\_\_\_ feet.

Objectives: "D" Sand Depth 6355'; "J" Sand Depth 6455'  
Formation Estimate Formation Estimate

Proposed length of surface casing 300 feet. of 9-5/8"

### REMARKS:

We propose to drill this well with rotary tools. Surface casing to be set with approximately 125 sax.

Agent	<u>Blanket</u>
Bond	<u>Blanket</u>
Spot	
600 ft.	<u>OK</u>
1200 ft.	<u>OK</u>
Wells	
Oil	
Gas	
Status	

I/We hereby swear (or affirm) that the statements herein made are a full and correct report.

### APPROVED:

Date NOV 20 1958

A. J. Jordin  
Director

Company UTAH SOUTHERN OIL COMPANY Date Nov. 18, 1958

Address 1825 First Nat'l. Bank Bldg. Phone No. AM 6 3173

By Harry E. McDonald Signature McDonald Title Production Superintendent.