




RECEIVED

JUL 18 1969

R. 52W

COLO. OIL & GAS CONS. COMM.

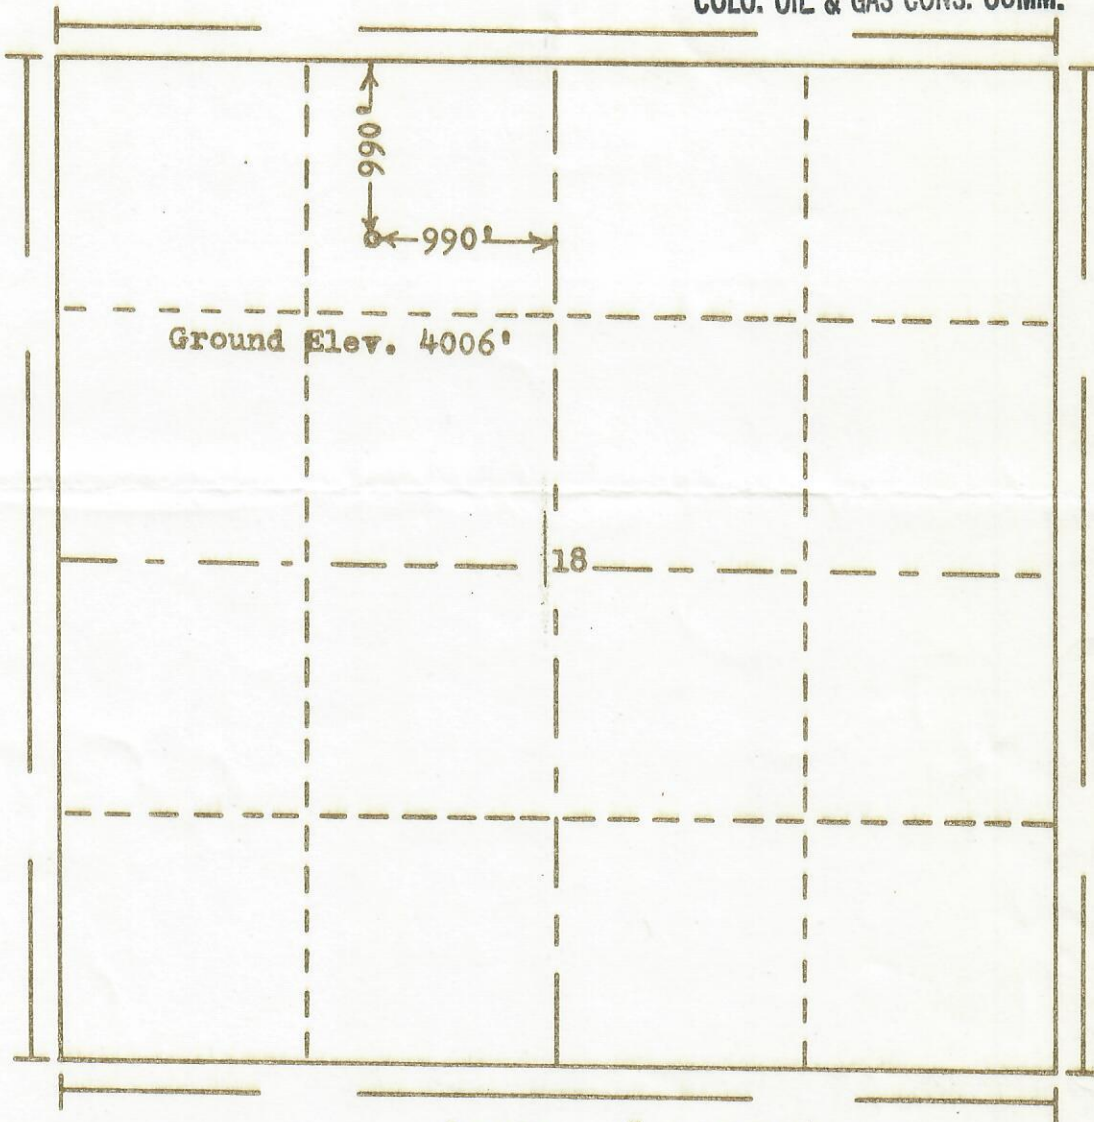

Scale... 1" = 1000'

Powers Elevation Company, Inc. of Denver, Colorado
has in accordance with a request from Mr. Harrison
for Cardinal Petroleum Co.
determined the location of No. 1 Bartholomew Bros.
to be CSW NE NW Section 18 Township 8N
Range 52W of the 6th Principal Meridian
Logan County, Colorado

I hereby certify that this plat is an
accurate representation of a correct
survey showing the location of

Date: 7-16-69

B. G. Hollenbeck
Licensed Land Surveyor No. 2853
State of Colorado