


# K3 OIL & GAS OPERATING

Well Bore Schematic

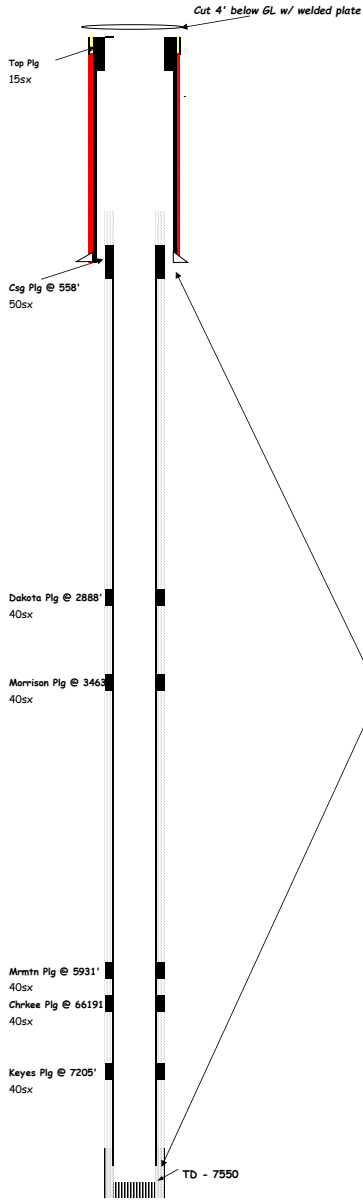

Well Name CoBank 13-18  
Diagram Date 1/25/2020

Surface Location 645' FSL 475' FWL  
Sec-T-R Section 18 - T155-R54W  
Field Wildcat  
County Lincoln County  
State Colorado

API No. 05-073-06743-00

G.L. Elevation 5071'  
K.B. Elevation 5090.0

SPUD 11/21/2019  
TD 12/17/2019

Surface Casing: 13 3/8", 48#, set @ 477' w/450 sxs (elog depth)

Open Hole: 7-7/8" 477' to 7550'