


WRL-04-TLE-100-L5-1

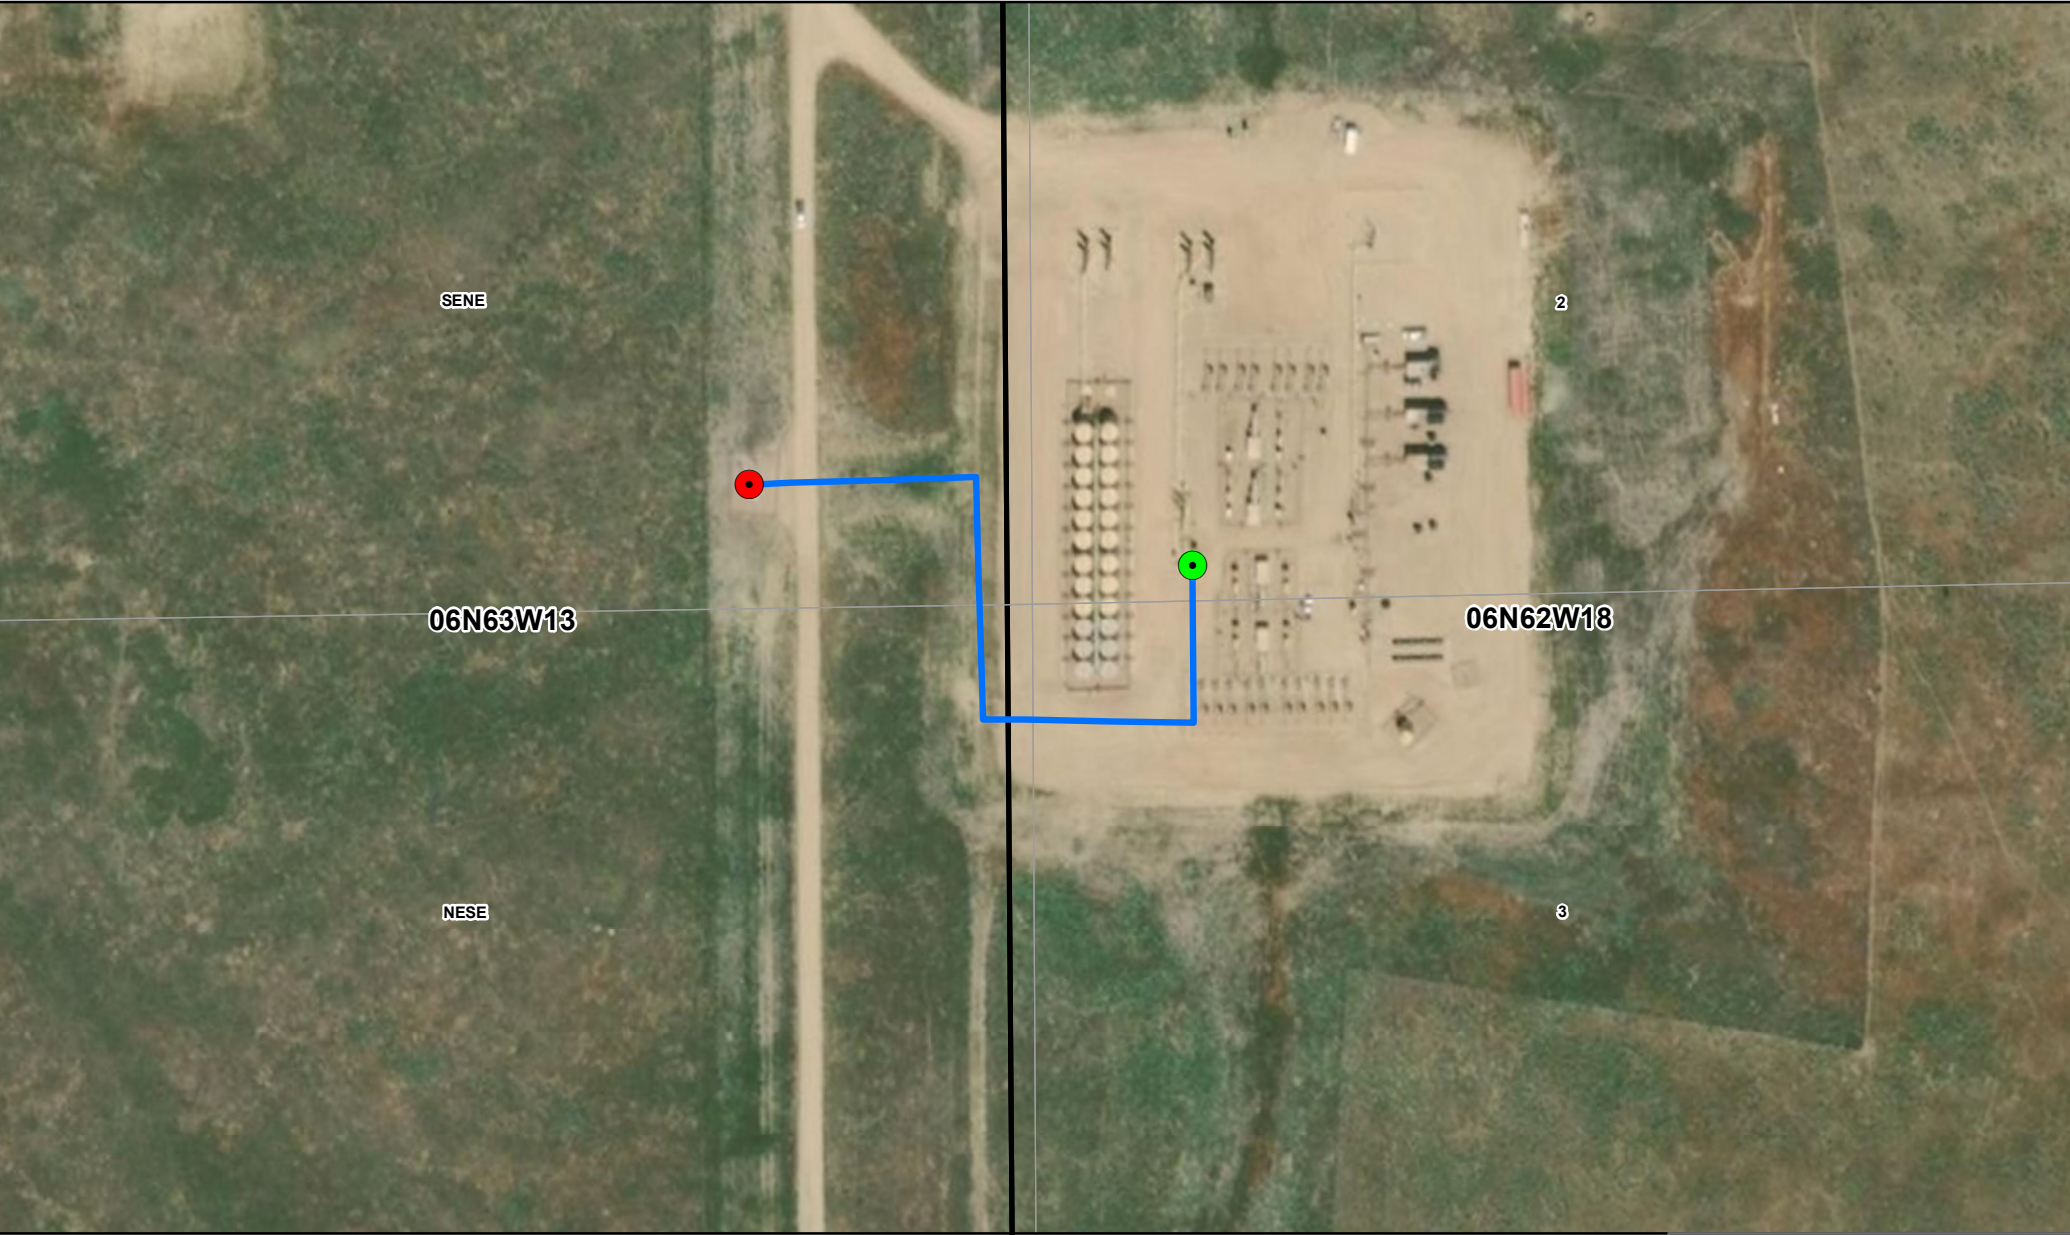

Legend

- Connection With Trunkline
- Custody Transfer Point
- WRL-04-TLE-100-L5-1

noble
MIDSTREAM
PARTNERS