



FORM F-106

82-1136 RC

RECEIVED


JUL 1 1982



00208373

R. 68W

COLO. OIL & GAS CONS. COMM.

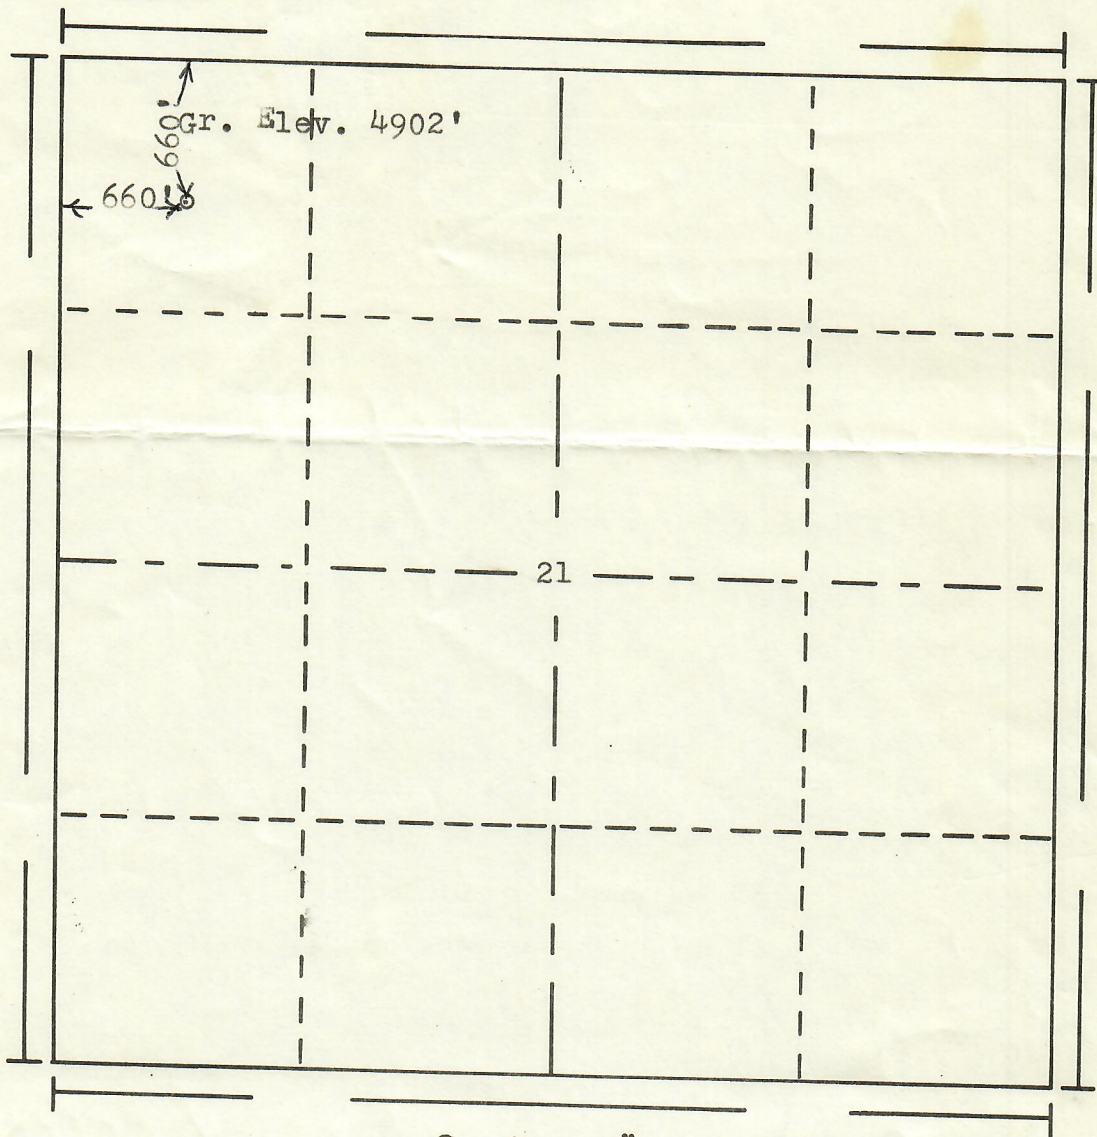
T.
6
N

Scale... 1" = 1000'

Powers Elevation of Denver, Colorado
has in accordance with a request from Mr. Stubbs
for The Termo Co.

determined the location of No. ? ?
to be CNW NW Section 21 Township 6N
Range 68W of the 6th Principal Meridian
Larimer County, Colorado

I hereby certify that this plat is an
accurate representation of a correct
survey showing the location of

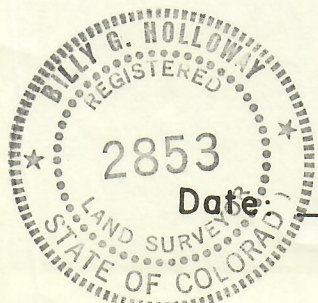

Date

5-29-82

Billy G. Holloway
Licensed Land Surveyor No. 2853
State of Colorado