



AND GAS CONSERVATION COMMISSION OF THE STATE OF COLORADO


NOTICE OF INTENTION TO DRILL

INSTRUCTIONS:

A notice of intention to drill a well shall be filed in duplicate on all Federal and Patented lands, and in triplicate on all State lands. Do not begin operations until approved copy has been received. It is mandatory that the proposed location comply with all rules and regulations of the Commission. Locate well on section grid in proper location, and indicate extent of lease. Unless operations are commenced within 180 days after the date of approval hereof, this approval to drill will become null and void.

Name of Operator Ancora Corporation Phone No. AM. 6-3516
Address 635 Petroleum Club Bldg. City Denver 2, State Colorado
How is liability secured: Well Bond (Attached) ☐; Blanket Bond ☐; Waiver ☒
(Check one)

Lease Name Morris
Well No. 1
Field Name Wilcat ☒
County Routt

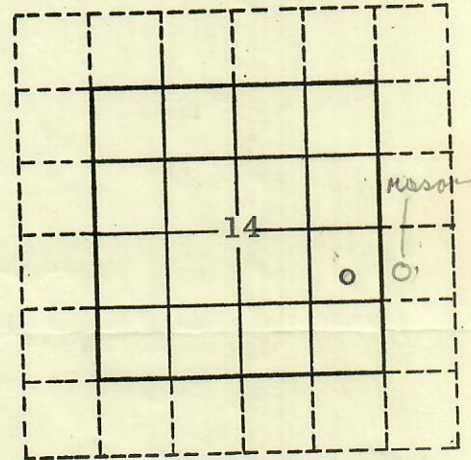

Location NE SE Section 14 Township 6N Range 86W Meridian 6th P.M.
(quarter quarter)
1766 feet from South Section line and 664.29 feet from East Section Line
403 feet from N or S E or W

The well is located on: Patented land ☒ State land ☐ Federal land ☐

The well is located within a spaced area: Yes ☐ No ☒

Distance from proposed location to nearest property or lease line 403 feet.
Distance from proposed location to nearest drilling unit line feet.

Objectives: Niobrara Depth 5,000; Depth
Formation Estimate Formation Estimate

Proposed length of surface casing 300 feet.

REMARKS:

Dist. E/4 corner to SE corner is surveyed 2726'.

107-05076



00544903

Agent	<u>OK</u>
Bond	<u>waived</u>
Spot	<u>shale</u>
600 ft.	
1200 ft.	
Wells	
Oil	
Gas	
Status	

I/We hereby swear (or affirm) that the statements herein made are a full and correct report.

APPROVED:

Date NOV 30 1959

A. J. Garcia
Director

Company Ancora Corporation Date 11-27-59

Address 635 Petr. Club Bldg. Phone No. AM. 6-3516

By John H. Rathbone Title Geologist
Signature