

Colorado Interstate Gas


LEASE: Flank #25
FIELD: Flank
COUNTY: Baca
STATE: Colorado
LOCATION: 29 33S 42W
API #: 05-009-06045-00
SPUD: 05/01/71 [Original]
SPUD: 05/25/83 [Re-Entry]
Rev. Date: 02/10/20 - APT

ELEVATION: GL: 3,815'

[Re-Surveyed (04/29/83)]

KB: 0'

TD: 4,810' GL PBTD: 4,769' GL

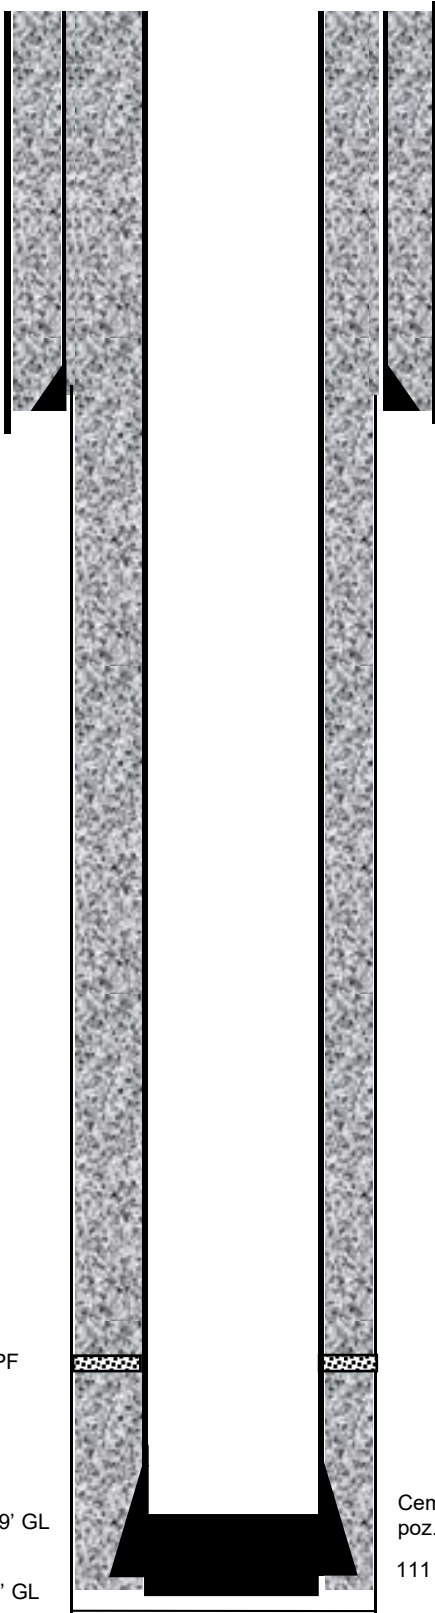

Cemented w/300 sx. [Details not available from original operator.]

8 5/8", 24#, J-55 casing @ 458' GL

TD 12-1/4" Surface hole @ 459' GL

Perf: 4,734'-4,738' GL w/ 2 SPF

PBTD @ 4,769' GL

TD 7-7/8" hole @ 4,810' GL

Cement w/825 sx. HLC + 200 sx. 50/50 poz. Cmt. Circ.

111 jts, 5-1/2", 15.5#, K55, 8R, LT&C @ 4,798' GL