

OIL AND GAS CONSERVATION COMMISSION
OF THE STATE OF COLORADO



RECEIVED
SEP 3- 1963

NOTICE OF INTENTION TO DRILL

OIL & GAS
CONSERVATION COMMISSION

INSTRUCTIONS:


A notice of intention to drill a well shall be filed in duplicate on all Federal and Patented lands, and in triplicate on all State lands. Do not begin operations until approved copy has been received. It is mandatory that the proposed location comply with all rules and regulations of the Commission. Locate well on section grid in proper location, and indicate extent of lease. Unless operations are commenced within 180 days after the date of approval hereof, this approval to drill will become null and void.

Name of Operator QUINTIN R. GRENFELL Phone No. 925-6977
Address 2211-B Waverly Street City Sacramento 25 State California

How is liability secured: Well Bond (Attached) ☐; Blanket Bond ☐; Waiver ☐
(Check one)

Lease Name B. L. MORRIS
Well No. ONE (1)
Field Name _____ Wildcat ☒
County ROUTT

(Saddle Mountain)

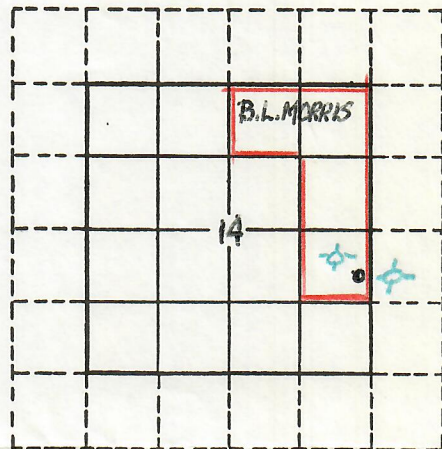

Location NE $\frac{1}{4}$ SE $\frac{1}{4}$ (quarter quarter) Section 14 Township 6N Range 86W Meridian 6th PM
1650 feet from South Section line and 100 feet from East Section Line
N or S E or W

The well is located on: Patented land ☒ State land ☐ Federal land ☐

The well is located within a spaced area: Yes ☐ No ☒

Distance from proposed location to nearest property or lease line 100 feet.

Distance from proposed location to nearest drilling unit line 400 feet.

Objectives: Mancos Depth 2600' ; Niobrara Depth 4500' TD
Formation Estimate Formation Estimate

Proposed length of surface casing 2000' feet.

REMARKS:

Agent	<u>Ind. Act</u>
Bond	
Spot	<u>Plotter 9-3-63</u>
600 ft.	
1200 ft.	
Wells	
Oil	
Gas	
Status	

I/We hereby swear (or affirm) that the statements herein made are a full and correct report.

APPROVED:

Date SEP 4 1963

[Signature]
Director

Company Quintin R. Grenfell Date August 23, 1963

Address 2211-B Waverly Street Phone No. 925-6977

By [Signature] Title Operator
Signature