

JEANNER. MASON'S

~~#1 McDERMOTT~~

JEANNE #1

107-05075

40.00 N89°58'W

40.76 S89°56'W



999999999

N1°03'E

1/2 Cor Used

82.61

331'

Well loc.

170.4'

W Cor Used


Scale 1"=1000'

80.30

S89°39'W

N1°24'E

81.84

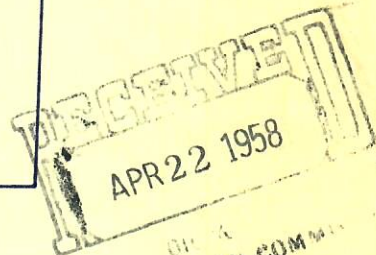

CONSERVATION COM.

SEC 13, T6N, R86W 6" Principle Meridian, Routt County, Colorado



00197486

Certified

By: Ross Const. Co.
Vernal, Utah

PARTY Nelson J Marshall
Leonard E Heerney

WEATHER Fair Cool

SURVEY

JEANNE #1

Jeanner. Mason's ~~#1 McDERMOTT~~ Well, located 331' from west line & 170.4' from the south line - Sec 13, T6N, R86W 6" Prin. Meridian, Colorado.

DATE 16 April 58

REFERENCES

640. Plat

FILE J.A. Mason