

Foundation Energy Management, LLC

WELLBORE DIAGRAM

Well / Battery	Prospect Name		Total Depth	Current Status
Allison 1-32	Vernon		2,219'	
	Sec-Twn-Rng		Producing Horizon	County & State
	32-1S-44W		Niobrara	Yuma, CO

WELLBORE DIAGRAM

Prepared Date:

Prepared By: Mike Jumper

General Info

API #: 05-125-06103

KB Elevation: 3,912'

GL Elevation: 3,906'


Spud Date: 1/15/1977

Completion Date: 2/12/1977

TVD:

MD: 2,219'

Last PBDT:

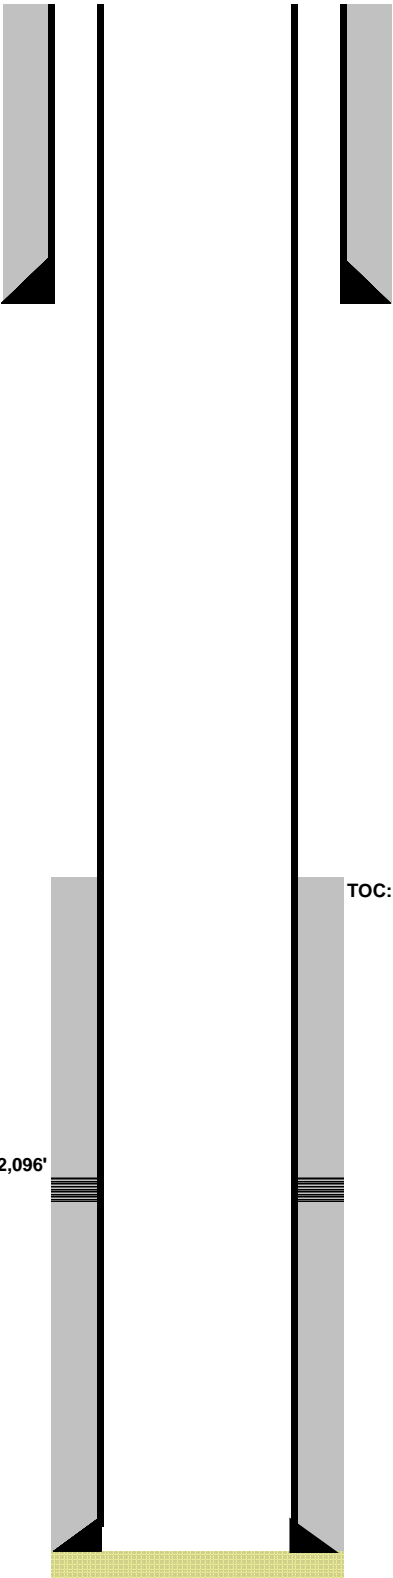

Surface Casing

7" inch (OD)

20 # (weight)

J-55 grade

220' depth from KB

SURF (VISU) cement top

95 sacks of cement

9-7/8" inch (OD) HOLE SIZE

Production Casing

4-1/2" inch (OD)

10.5 # (weight)

J-55 grade

2,219' depth from KB

1,400'(Calc) cement top

80 sacks of cement

6-1/4" inch (OD) HOLE SIZE

Well Notes:

Perforations:

2,096'-2,116' (Niobrara)