

OIL AND GAS CONSERVATION COMMISSION OF THE STATE OF COLORADO

RECEIVED JUL 3 1959

OIL & GAS CONSERVATION COMMISSION



NOTICE OF INTENTION TO DRILL


INSTRUCTIONS:

A notice of intention to drill a well shall be filed in duplicate on all Federal and Patented lands, and in triplicate on all State lands. Do not begin operations until approved copy has been received. It is mandatory that the proposed location comply with all rules and regulations of the Commission. Locate well on section grid in proper location, and indicate extent of lease. Unless operations are commenced within 180 days after the date of approval hereof, this approval to drill will become null and void.

Name of Operator J. T. Miers d/b/a Milinda Oil Co. Phone No. LA 2-3696
Address P. O. Box 325 City Sterling State Colorado

How is liability secured: Well Bond (Attached) [x]; Blanket Bond []; Waiver []
(Choose one)

Lease Name Clifford Knudson
Well No. 1
Field Name Minto Wildcat [x]
County Logan

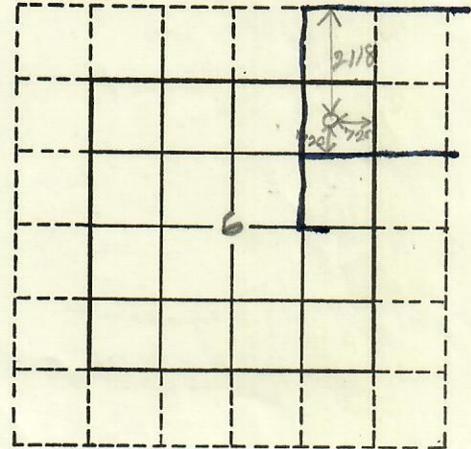

Location Lot 1 (quarter quarter) Section 6 Township 8 North Range 52 W Meridian 6th
2118 feet from N Section line and 720 feet from E Section Line

The well is located on: Patented land [x] State land [] Federal land []

The well is located within a spaced area: Yes [] No [x]

Distance from proposed location to nearest property or lease line 600 feet.
Distance from proposed location to nearest drilling unit line 600 feet.

Objectives: J Sand Formation Depth 4980 Estimate; D Sand Formation Depth 4875 Estimate

Table with columns: Agent, Bond, Spot, 600 ft., 1200 ft., Wells, Oil, Gas, Status

Proposed length of surface casing 200 feet.

REMARKS: This well is being drilled on the West edge of a gravel pit. Permission is requested to move the location 60' West and 60' North of the East and South lines of the NE/4 NE/4 6-8-52, for the reason that it would be impossible to drill in the exact center of said 40 acres because of the location of the gravel pit hereinbefore referred to. The lands embraced within the lease under which this well is being drilled are described as: Lot 1, Section Six; and Lots 3 and 4 and the S/2 NW/4 Section Five, Twp. 8 North, Range 52 West 6th P.M., Logan County, Colorado.

I/We hereby swear (or affirm) that the statements herein made are a full and correct report.

APPROVED: JUL - 3 1959
Date

Company Milinda Oil Co. Date 6/26/59

Address P.O. Box 325 Phone No. LA2-3696

By J. T. Miers Signature Title Pres.

A. J. Garrison Director