



FORM F-106




RECEIVED

DEC. 27 1978

COLO. OIL & GAS COM. 1011

R. 52W

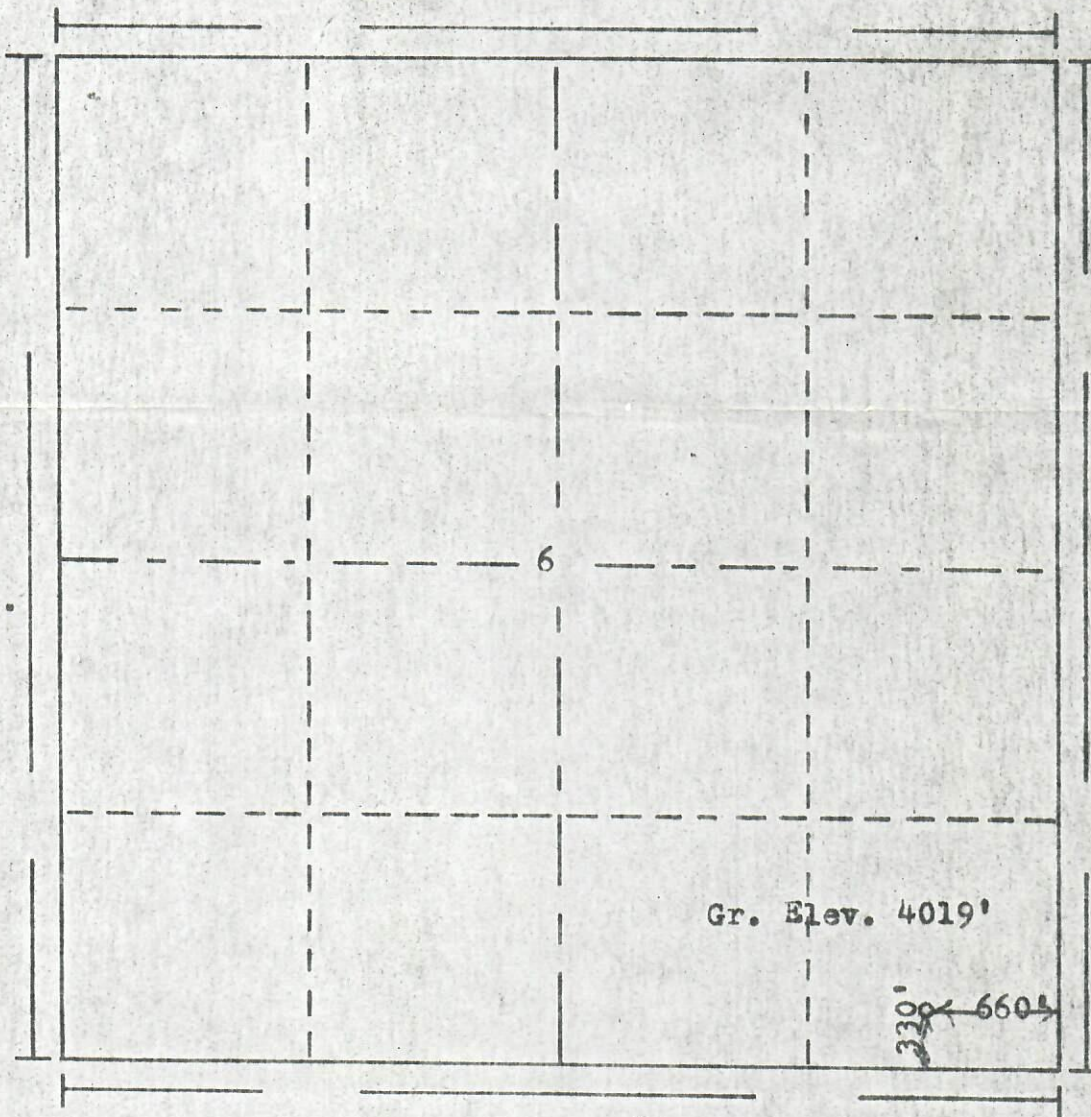

Scale 1" = 1000'

Powers Elevation Company, Inc. of Denver, Colorado
has in accordance with a request from Mr. Gear
for N.W. Glade

determined the location of No. 1 Luckey
to be 330'FS & 660'FE Section 6 Township 8N
Range 52W of the 6th Principal Meridian
Logan County, Colorado

I hereby certify that this plat is an
accurate representation of a correct
survey showing the location of

Date: 12-15-78

B. J. Hall
Licensed Land Surveyor No. 2853
State of Colorado