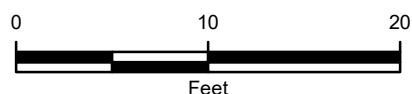




IMAGE COURTESY OF GOOGLE EARTH 2018

# LEGEND

- SOIL SAMPLE
- ⊕ GROUNDWATER SAMPLE
- x — x FORMER FENCE
- EXCAVATION EXTENT
- FORMER BERM



**FIGURE 1**  
**EXCAVATION SITE MAP**  
 CAMP 13-19A  
 NWSW SEC 19-T3N-R66W  
 WELD COUNTY, COLORADO  
 KERR-MCGEE OIL & GAS ONSHORE, LP

