


Well Name: LOLOFF B35-22

VERTICAL, ORIGINAL HOLE, 3/10/2020 3:50:40 PM

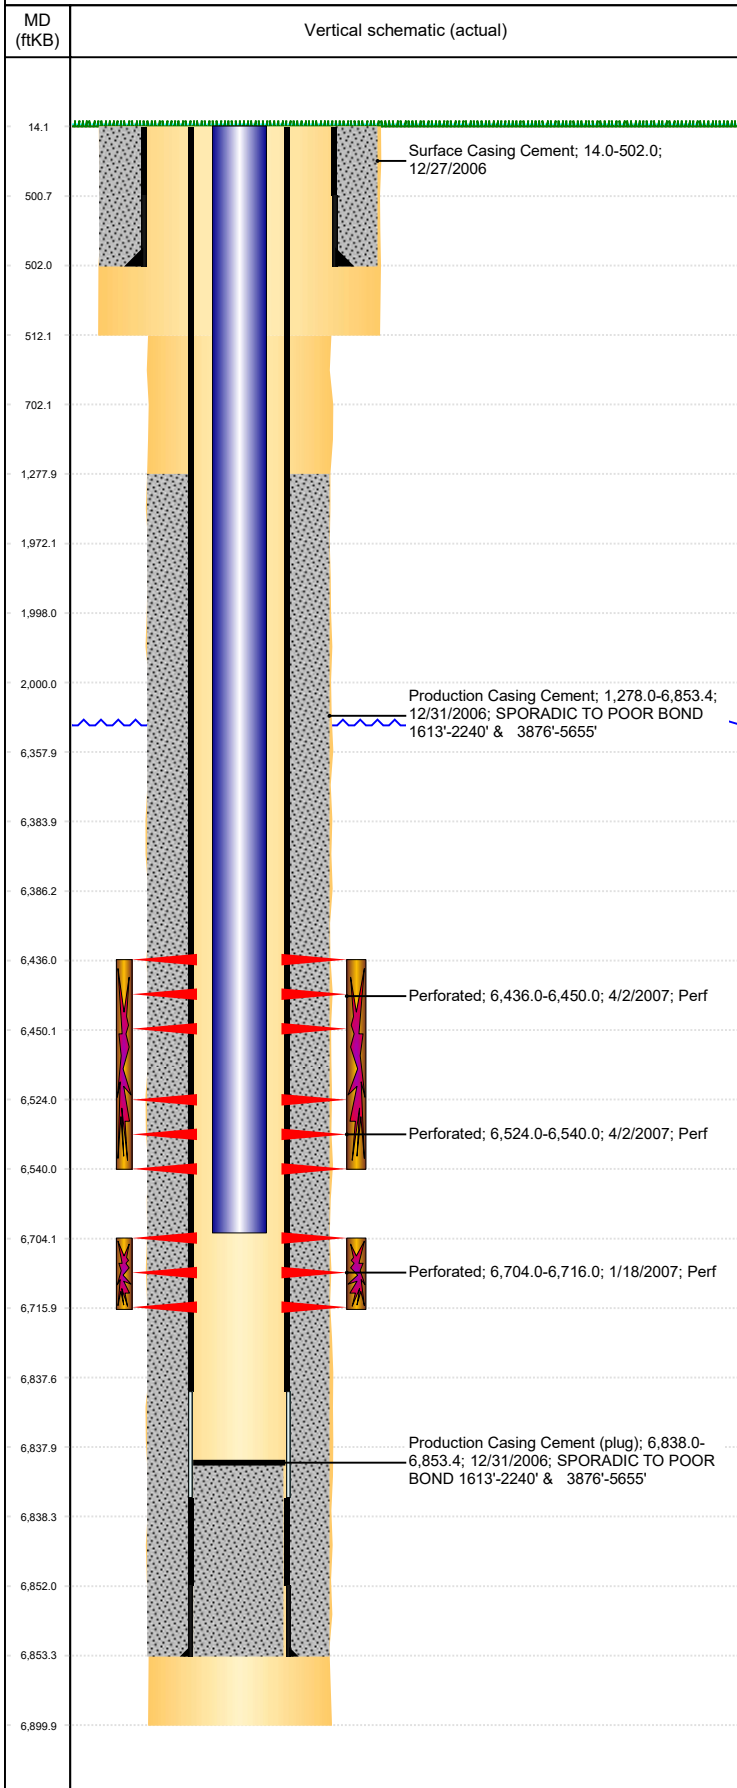

Well Header									
API 05-123-24425		Business Unit DJ BASIN			District 15		Well Config VERTICAL		
KB - GL / MSL (ft... 14.00		Spud Date 12/26/2006		P & A Date		Well Production Status PR			SoRT No
Comment Push CIPP to 6838.									
Surface Location (Congressional)									
Qtr 3 SE	Qtr 4 NE	Section 35	Twnshp 5	Twnsh... N	Range 64	Rng E... W	Actual Latitude (°) 40.35644731	Actual Longitude (°) -104.51197829	
Wellbore Sections									
Section Des			Size (in)			Act Top, MD (ftKB)		Act Btm, MD (ftKB)	
SURFACE			12 1/4			14		512	
PRODUCTION			7 7/8			512		6,900	
Casing Strings									
Csg Des			Run Date		OD (in)	Wt/Len (lb/ft)	Grade	Top, MD (ftKB)	MD (ftKB)
Surface			12/27/2006		8 5/8	24.00	J-55	14.0	502.0
Production			12/30/2006		4 1/2	11.60	M-80	14.0	6,853.4
Cement									
Des					Start Date		Top (ftKB)		Btm (ftKB)
Surface Casing Cement					12/27/2006		14.0		502.0
Production Casing Cement					12/31/2006		1,278.0		6,853.4
Zone Statuses									
Zone Name	Status Date	Status	Fluid Type	Job				Prod Method	
NIOBRARA	4/4/2007	PR	Water	DRILLING/COMPLETION - ORIGINAL, 12/26/200...				Flowing	
NIOBRARA	1/30/2010	PR							
CODELL	2/22/2012	PR							
CODELL	2/9/2016	PR							
Perforation Data									
Linked Zone			Bnch/Stg	Entered Shot Total	Top (ftKB)		Btm (ftKB)		Date
NIOBRARA, ORIGINAL HOLE				56	6,436.00		6,450.00		4/2/2007
NIOBRARA, ORIGINAL HOLE				64	6,524.00		6,540.00		4/2/2007
CODELL, ORIGINAL HOLE				48	6,704.00		6,716.00		1/18/2007
Stimulation Intervals									
Zone				Start Date		Top (ftKB)		Btm (ftKB)	
NIOBRARA, ORIGINAL HOLE				4/2/2007		6,436.0		6,540.0	
				4/2/2007		6,704.0		6,716.0	
CODELL, ORIGINAL HOLE				4/2/2007					
Other In Hole									
Run Date		Des				OD (in)	Top (ftKB)		Btm (ftKB)
5/23/2019		Plunger Lift				1 7/8			
Logs									
Date		Type				Top, MD (ftKB)		Btm, MD (ftKB)	
12/30/2006		COMPENSATED DENSITY				2,500.0		6,847.0	
12/30/2006		INDUCTION				502.0		6,867.0	
1/16/2007		CBL/CCL/GR				1,122.0		6,823.0	
6/17/2016		GYRO				0.0		6,600.0	
Plug Back Total Depths									
Date		Type		Com				Depth (ftKB)	
1/16/2007		FILL		DEPTH LOGGER ON CBL				6,825.0	
6/12/2007		PLUG REMNANTS		DRILL PLUG AND CIRCULATE DOWN TO 6838'				6,838.0	