


Well Name: DECHANT D07-13

VERTICAL, ORIGINAL HOLE, 3/11/2020 1:14:33 PM

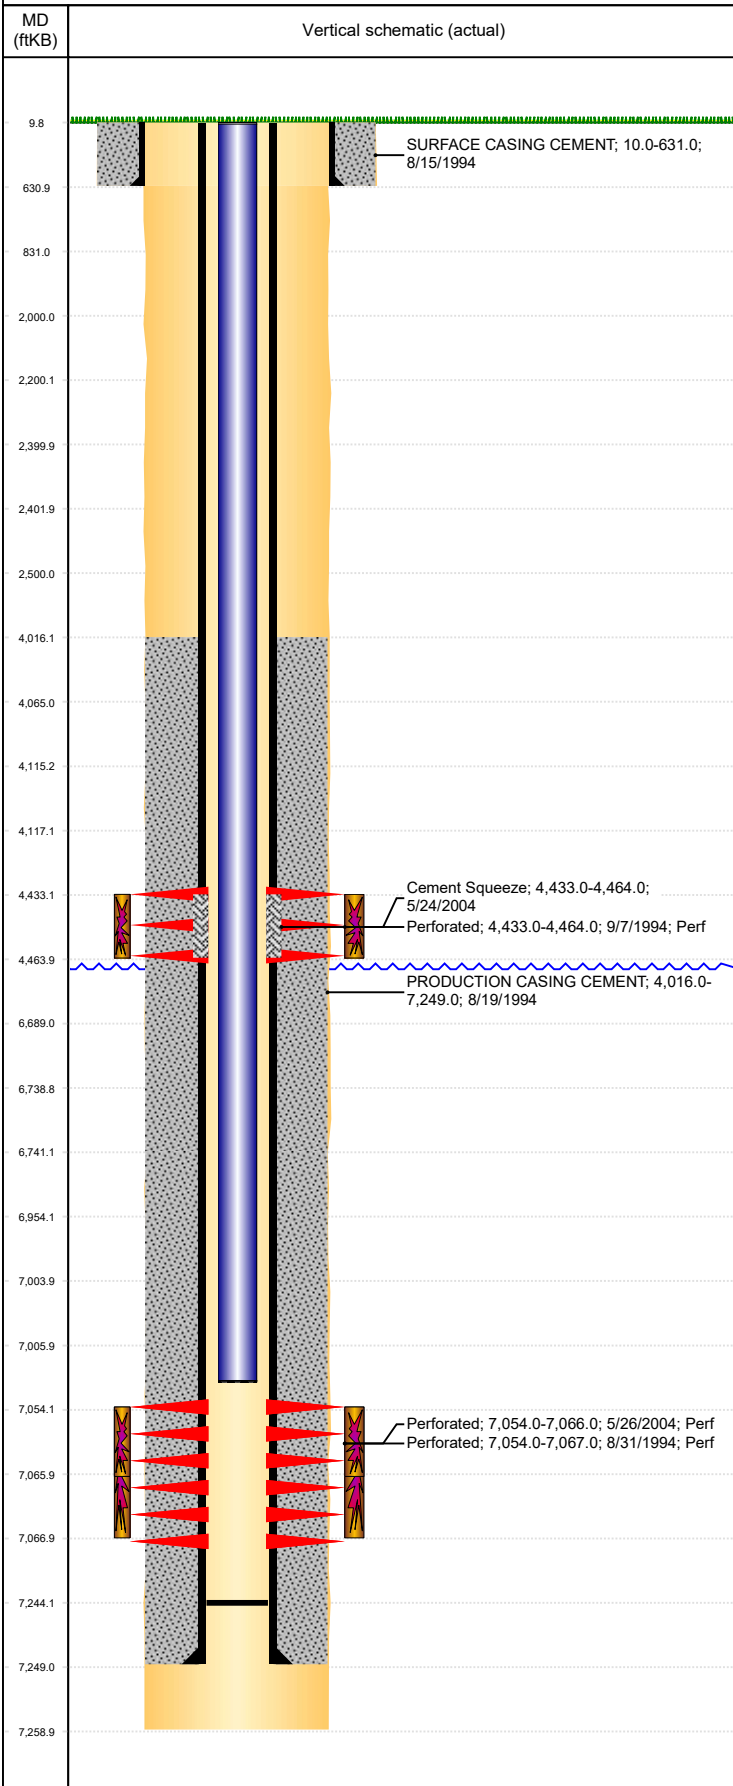

Well Header									
API 05-123-18425		Business Unit DJ BASIN			District 15		Well Config VERTICAL		
KB - GL / MSL (ft... 10.00		Spud Date 8/15/1994		P & A Date		Well Production Status PR			SoRT No
Comment									
Surface Location (Congressional)									
Qtr 3 SW	Qtr 4 SW	Section 7	Twnshp 3	Twnsh... N	Range 64	Rng E/... W	Actual Latitude (°) 40.23447682	Actual Longitude (°) -104.59987625	
Wellbore Sections									
Section Des			Size (in)			Act Top, MD (ftKB)		Act Btm, MD (ftKB)	
SURFACE			12 1/4			10		631	
PRODUCTION			7 7/8			631		7,259	
Casing Strings									
Csg Des			Run Date		OD (in)	Wt/Len (lb/ft)	Grade	Top, MD (ftKB)	MD (ftKB)
Surface			8/15/1994		8 5/8	24.00		10.0	631.0
Production			8/19/1994		3 1/2	9.20	N80	10.0	7,249.0
Cement									
Des					Start Date		Top (ftKB)		Btm (ftKB)
SURFACE CASING CEMENT					8/15/1994		10.0		631.0
PRODUCTION CASING CEMENT					8/19/1994		4,016.0		7,249.0
Cement Squeeze					5/24/2004		4,433.0		4,464.0
Zone Statuses									
Zone Name	Status Date	Status	Fluid Type	Job				Prod Method	
CODELL	9/24/1994	PR	Gas	DRILLING/COMPLETION - ORIGINAL, 8/15/1994...					
SUSSEX	9/24/1994	PR	Gas	DRILLING/COMPLETION - ORIGINAL, 8/15/1994...					
SUSSEX	5/24/2004	AB		RE-FRAC, 5/21/2004 00:00					
Perforation Data									
Linked Zone			Bnch/Stg	Entered Shot Total	Top (ftKB)		Btm (ftKB)		Date
SUSSEX, ORIGINAL HOLE				14	4,433.00		4,464.00		9/7/1994
CODELL, ORIGINAL HOLE				48	7,054.00		7,066.00		5/26/2004
CODELL, ORIGINAL HOLE				52	7,054.00		7,067.00		8/31/1994
Stimulation Intervals									
Zone				Start Date		Top (ftKB)		Btm (ftKB)	
SUSSEX, ORIGINAL HOLE				9/8/1994		4,433.0		4,464.0	
CODELL, ORIGINAL HOLE				9/6/1994		7,054.0		7,067.0	
CODELL, ORIGINAL HOLE				6/8/2004		7,054.0		7,066.0	
Other In Hole									
Run Date		Des				OD (in)	Top (ftKB)		Btm (ftKB)
1/30/2019		Plunger Lift				1 5/8			
Logs									
Date		Type				Top, MD (ftKB)		Btm, MD (ftKB)	
8/19/1994		Compensated Density				3,800.0		7,260.0	
8/19/1994		Induction				3,800.0		7,260.0	
8/26/1994		Cement Bond				3,800.0		7,196.0	
3/14/2017		GYRO				0.0		6,900.0	
Plug Back Total Depths									
Date		Type		Com				Depth (ftKB)	
8/19/1994		LATCH DOWN COLLAR						7,244.0	