WELLBORE DIAGRAM
POWER ENERGY RESOURCES
SIMPSON 42-4
SESW SEC 4 7N 65W
WELD COUNTY
05-123-11525

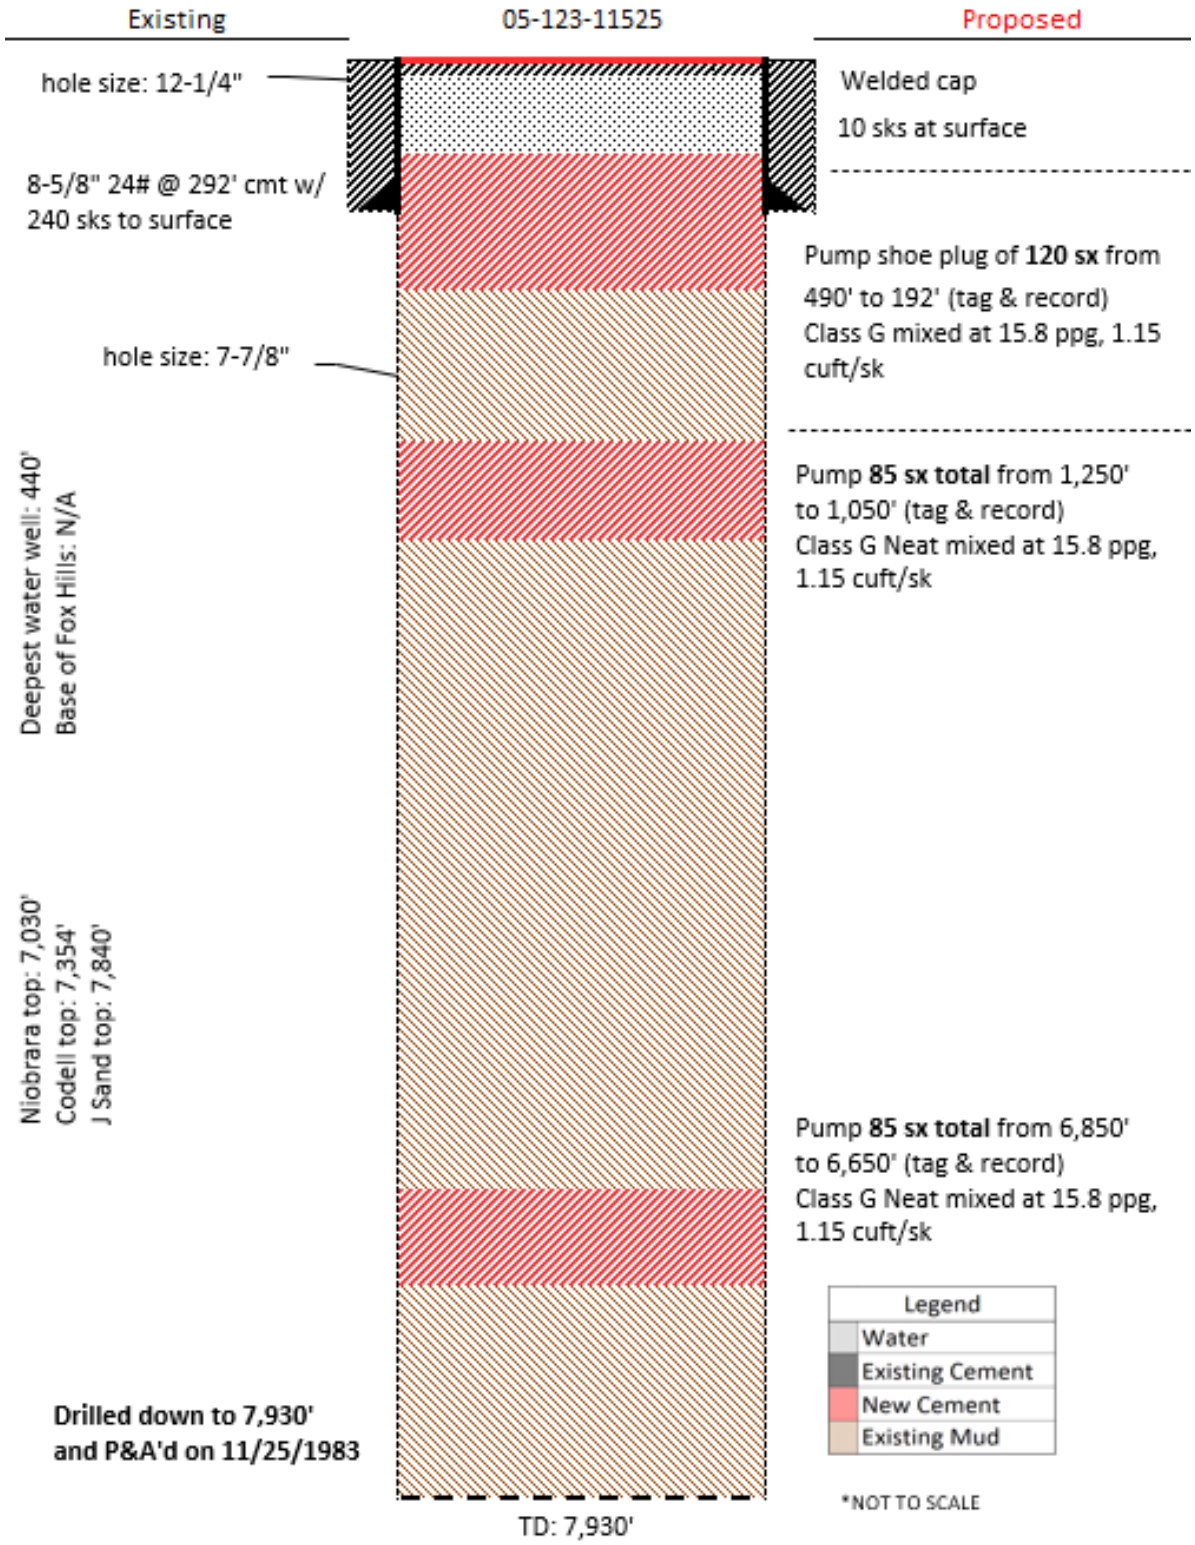

*NOT TO SCALE