


Ground Level

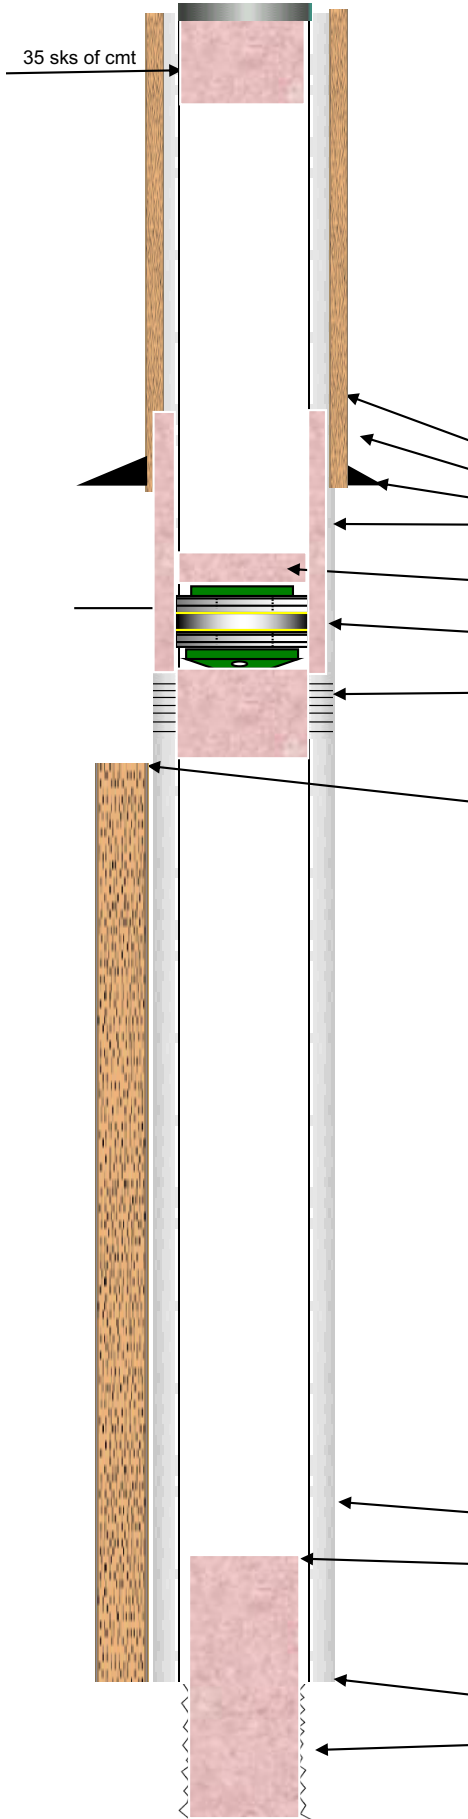

COMPANY					DATE	
Public Service Company Of Colorado					4/7/2020	
LEASE						
Asbury Storage Unit-Fed #4. API# 05-077-05093 / BLM Lease # 14-08-001-86-02						
Surface Casing		Weight	Grade	Thread	Depth	
	8-5/8"	24#	J-55	LT&C	539'	
Prod Casing		Weight	Grade	Thread	Depth	
	4-1/2"	9.5#	J-55	LT&C	2777'	
Tubing String		Size	Weight	Grade	Thread	Depth
		2 3/8	4.7#	J-55	8rd EUE	2678'
Second String		Size	Weight	Grade	Thread	Depth
Prepared for:			Perforations:			
			Dakota Open hole Section 2772' to 2810'			
ITEM No#	Length	Description		ID	OD	Depth
1		375 sks of surface cement from 539' - 0'				
2		12-1/4" surface hole		12.25		
3		8-5/8" Surface Casing @ 539'		7.972	8.625	539.00
4		50 Sacks of Cement Squeezed thru CICR				
5		1 bbls of cement on top of CICR.				
6		CICR @ 489'				489.00
7		Squeeze holes @589'				589.00
8		Estamated top of cement @ 757'. 135 sacks				757.00
9		Hole size 6-3/4" drilled in October 1965		6.75		
10		75 sks G Neat Cement from 2677' to 2810'				
11		4-1/2" Casing landed @ 2777'		3.965	4.5	
12		Open Hole Section 2777' to 2810'				2810.00
PREPARED BY				PHONE:		
Jeff Schneider				970-381-9588		
OFFICE			PHONE		INVOICE #	
Fort Morgan, CO			970-867-9437			