




FOR 00500699

RECEIVED

MAY 15 1972

COLO. OIL & GAS CONS. COMM.

R. 47W

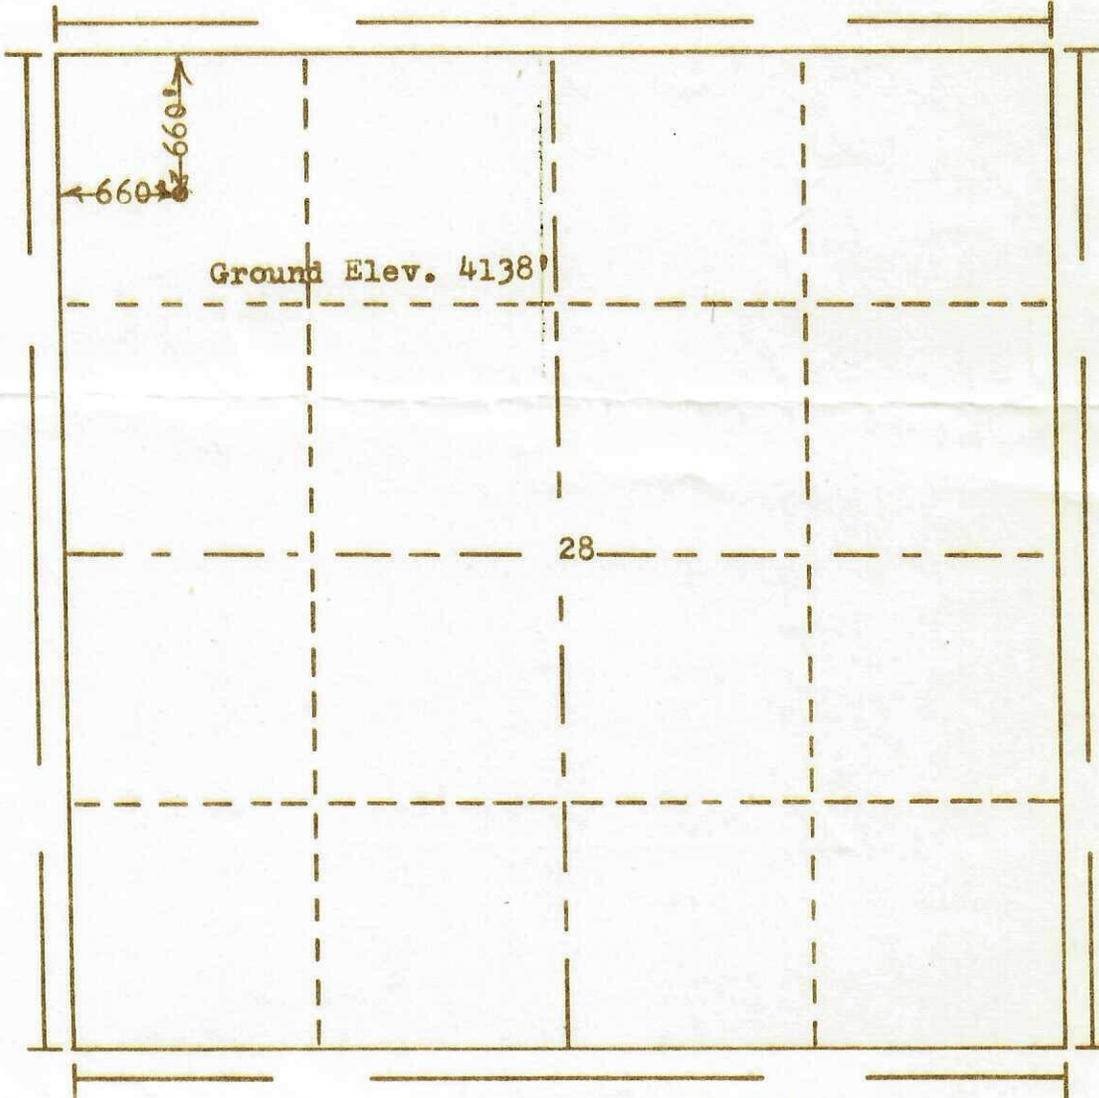

T.
16
S

Scale... 1" = 1000'

Powers Elevation Company, Inc. of Denver, Colorado
 has in accordance with a request from Mr. Vickory
 for Petro-Lewis Corp.
 determined the location of No. 4-28 Cleaves
 to be CNW NW Section 28 Township 16S
 Range 47W of the 6th Principal Meridian
 Cheyenne County, Colorado

I hereby certify that this plat is an
 accurate representation of a correct
 survey showing the location of

Date: 5-8-72

Licensed Land Surveyor No. 2853
 State of Colorado