

CALCO dba Callister Company



3/5/2020

Not to Scale

Well: Callister No 4 NE 1/4 NE 1/4, Sec 8, T. 1 N, R. 101 W. 6<sup>th</sup>


API 05-103-06358

### Present Well Bore Diagram

Surface: Buck Tongue Mdb.


castigate mbr.

Manco's shale Fm.

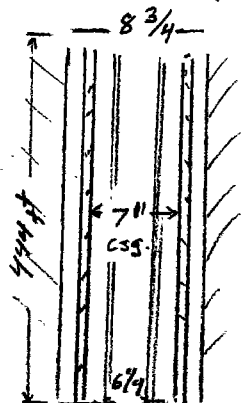

Z Z

Perforated 5 1/2 CSG from 2,270' - 3,280'  
oil in hole c 2,304 ft  
stotted 2315' to 2990'

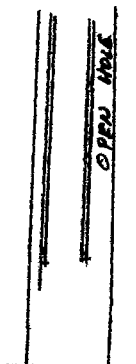

5 1/2 CSG set c 3,848 ft

TO 3,984 ft