




WELLBORE DIAGRAM
CURRENT WBD

1815 FSL 520 FWL

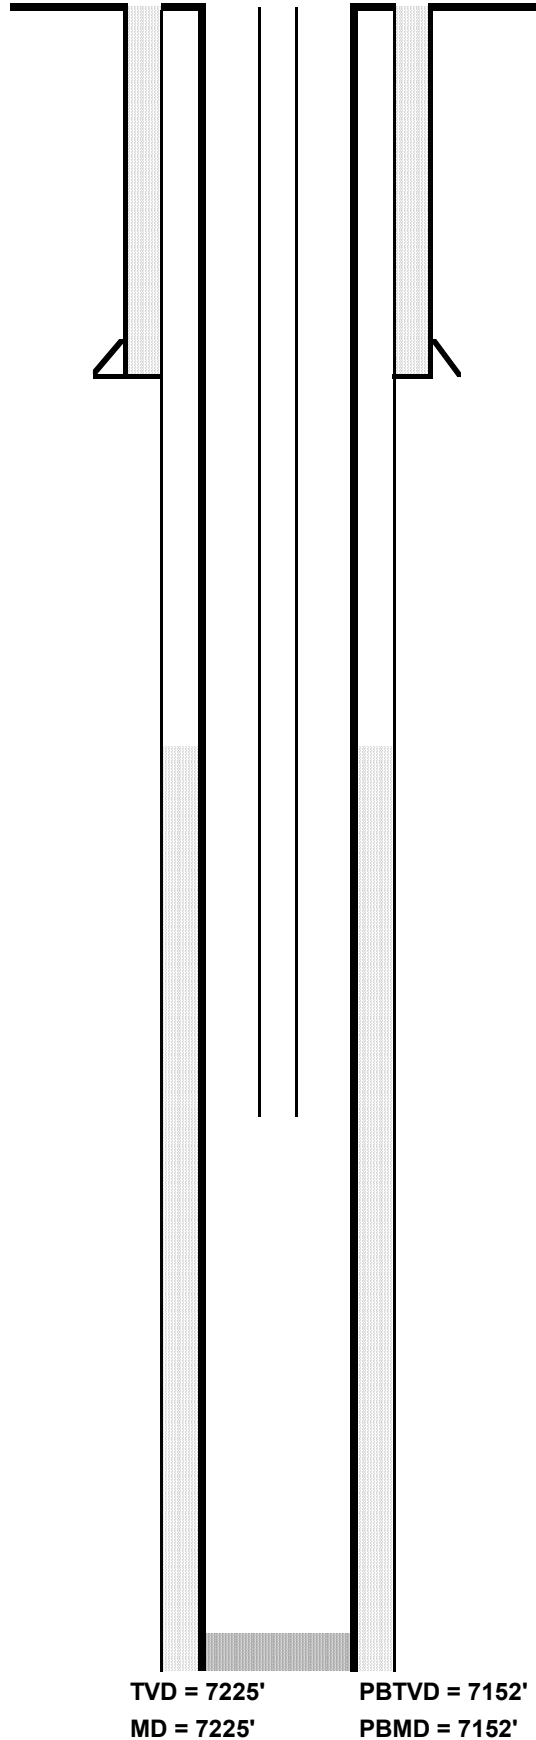

Operator:	Great Western Oil & Gas Company
Well Name:	Windor 35-2
Lease Number:	
Location:	NWSW Sec 35 T6N R67W
Field:	Wattenberg
County, State:	Weld, CO
API Number:	05-123-26173
Diagram Date:	2/20/2020
Lat/Long	40.44266/-104.86759

KB 4747'

GL 4735'

Spud Date: 5/10/2008

Surface Casing :

8-5/8" 24# 10 jts set @ 503'

Cmt w/350 sx

Production Casing :

4-1/2", 11.6# 179 jts set @ 7197'

Cmt'd w/ 542 sx

Tubing Detail:

TOC @ 3466'

Formation Tops:

Sussex 4126'

Shannon 4501'

Niobrara 6745'

Codell 7063'

Perforations

Codell 7064' - 7084'