


Ground Level

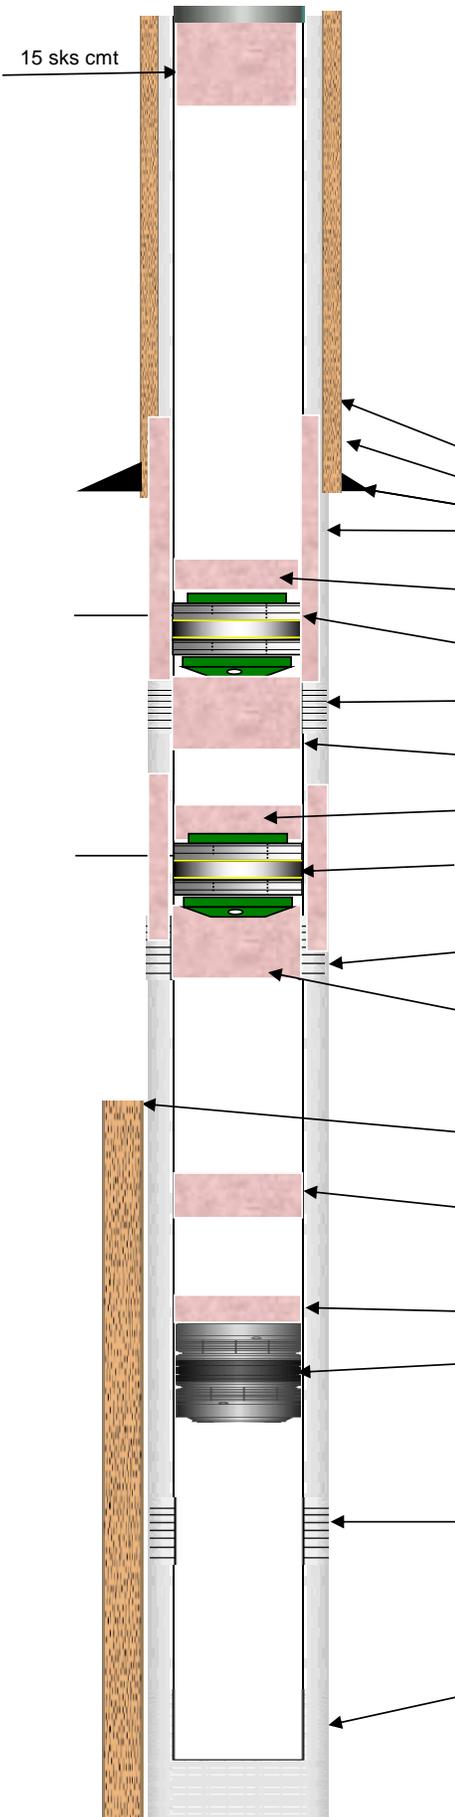

COMPANY Public Service Company of Colorado					DATE 4/14/2020	
LEASE Storage Unit #33 API# 05-087-08006						
Surface Casing	Weight	Grade	Thread	Depth		
8-5/8"	24#	J-55	LT&C	317'		
Prod Casing	Weight	Grade	Thread	Depth		
5-1/2"	15.5#	K-55	LT&C	6550'		
Tubing String	Size	Weight	Grade	Thread	Depth	
	2 7/8	6.5#	J-55	8rd EUE	6423'	
Second String	Size	Weight	Grade	Thread	Depth	
Prepared for:			Perforations: J Sand 6420' to 6428'.			
ITEM No#	Length	Description		ID	OD	Depth
1		285 sks of surface cement from 317' - 0'				
2		12-1/4" surface hole		12.25		
3		8-5/8" Surface Casing @ 317'		7.972	8.625	317.00
4		50 Sks of Cement Squeezed thru CICR				
5		5sacks of cement on 217' to 267'.				
6		CICR @ 267'				267.00
7		Squeeze holes @ 367'				367.00
8		50 sacks Squeeze (Same as #4)				
9		5 sacks of cement from 2350' to 2400'				2350.00
10		CICR @ 2400'				2400.00
11		Squeeze holes @ 2500'				2500.00
12		50 sack squeeze.				2500.00
13		Cement top 4760' CBL dated 7/24/1990 W/250 sks 50/50 poz & 150 sks G.				4760.00
14		15 sack casing plug @ 5460' to 5560'				5460.00
15		4 sacks of cement on top of CIBP.				
16		CIBP Set @ 6370'.				6370.00
17		J Sand Perfs 6420' to 6428'				
18		5-1/2" Casing landed @ 6550'.		4.825	5.5	6550.00
PREPARED BY Jeff Schneider			PHONE: 970-381-9588			
OFFICE Fort Morgan, CO		PHONE 970-867-9437		INVOICE #		