

Foundation Energy Management, LLC

WELLBORE DIAGRAM

Well / Battery	Prospect Name	Total Depth	Current Status
Template			
Location	Sec-Twn-Rng	Producing Horizon	County & State
Allison 1-32			

WELLBORE DIAGRAM

Prepared Date: 4-29-2020
Prepared By: Mike Bohler

General Info

API #: 05-125-06103

KB Elevation:

GL Elevation:


Spud Date:

Completion Date:

TVD:

MD:

Last PBTD:

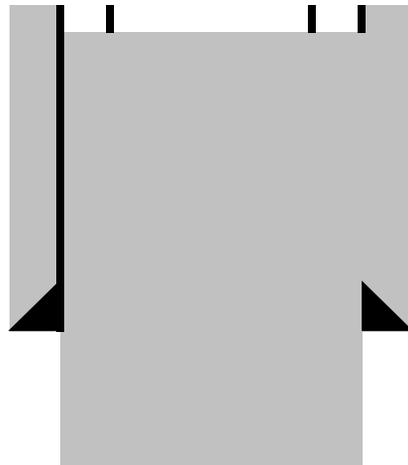

Topped off with 2sx

CONDUCTOR CSG

Pumped 195sx to surface

Surface Casing

- 7 inch (OD)
- 20 # (weight) grade
- 220 depth from KB
- 0 cement top Visual Returns
- 95 sacks of cement
- 9 7/8 inch (OD) HOLE SIZE

Perf @ 700

Production Casing

- 4.5 inch (OD)
- 10.5 # (weight) grade
- 2219 depth from KB
- 1400 cement top
- 80 sacks of cement
- 6 1/4 inch (OD) HOLE SIZE

Calculated

2sx of cement

CIBP @ 2050

Open Perforations



PBTD

TD=