




00218974

RECEIVED

OCT 6 - 1966

R. 66W

COLO. OIL & GAS CONS. COMM.

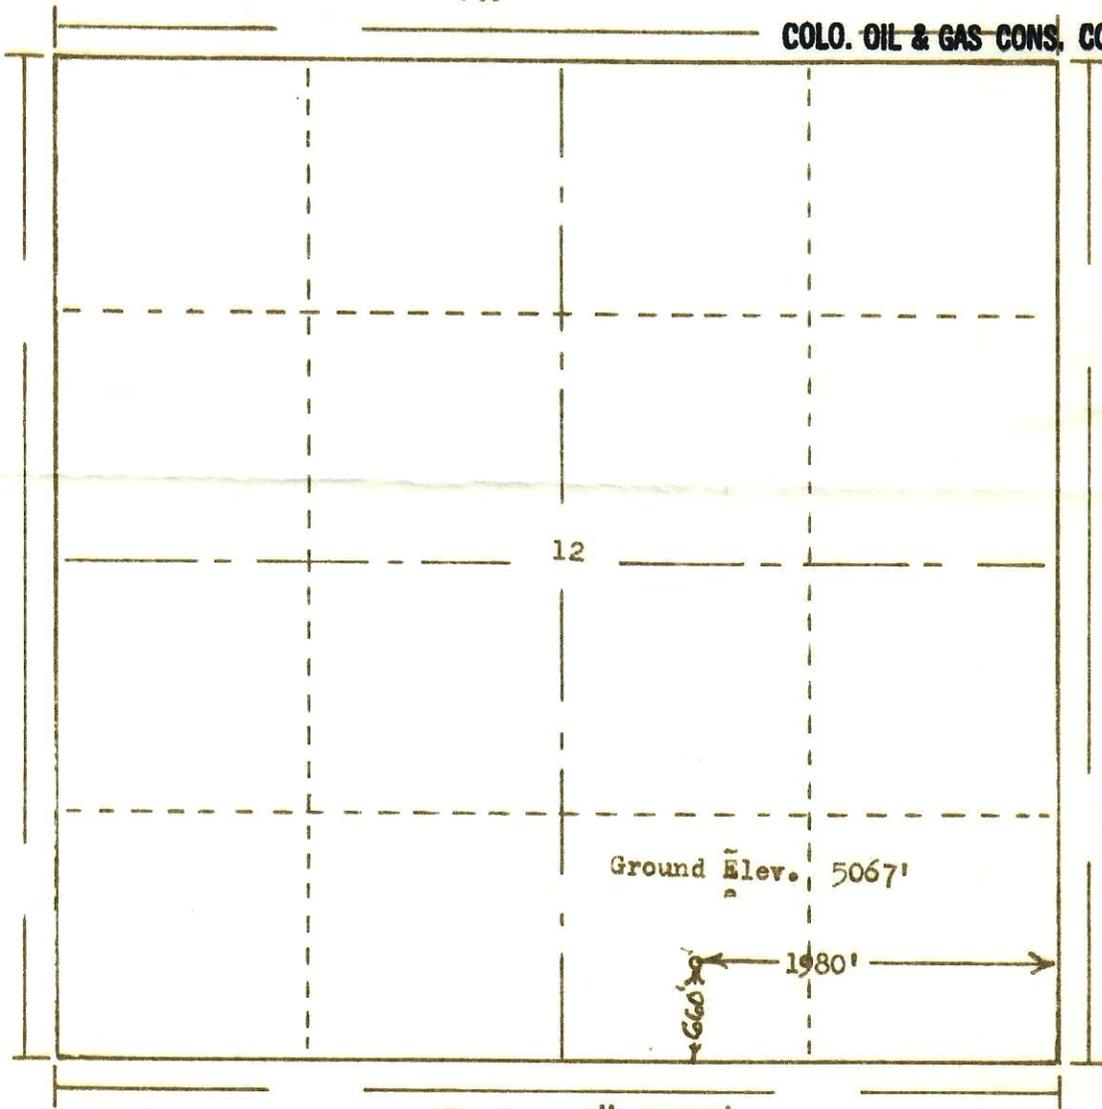

T.
8
N

Scale ... 1" = 1000'

Powers Surveyors, Inc. of Denver, Colorado
 has in accordance with a request from **Mr. Drake**
 for **THE ANSCHUTZ CORPORATION, INC.** determined the
 Location of **No. 1 Wickstrom**
 to be CSW SE Section 12 Township 8N
 Range 66W of the 6th Principal Meridian
 Weld County, Colorado

I hereby certify that this plat is an
 accurate representation of a correct
 survey showing the location of

Date: 9-29-60

Bruce D. Holloway
 Licensed Land Surveyor No. 2853
 State of Colorado