

Kerr McGee O+G Onshore LP
UPRR Pan Am B #1
123-07568
NESW 3-1N-68W
Weld County
API: 123-07568

Spud: 9/30/1972
2nd String

5055 ft Elev
1980 FSL, 1980 FNL
40.078242 Lat.
-104.991966 Long.


USGS Map
Laramie -
Fox Hills at
Surface

Induction "Log" (A little confusing)
604479 10/8/1972 Open Hole Schlum.
K1 = Laramie Upper Cret Fm. Bott. 284'
Kfh = Fox Hills Upper Cret SS Top 284'
Klf = Laramie-Fox Hills Top 478' ?
Base 668' ←
Kp = Pierre A ± 520-535
Kp = Pierre B ± 622-668' ←

Revised from 2018
Version

PAGE 1 of 2.


KOETLER
5/20/2020
1/60

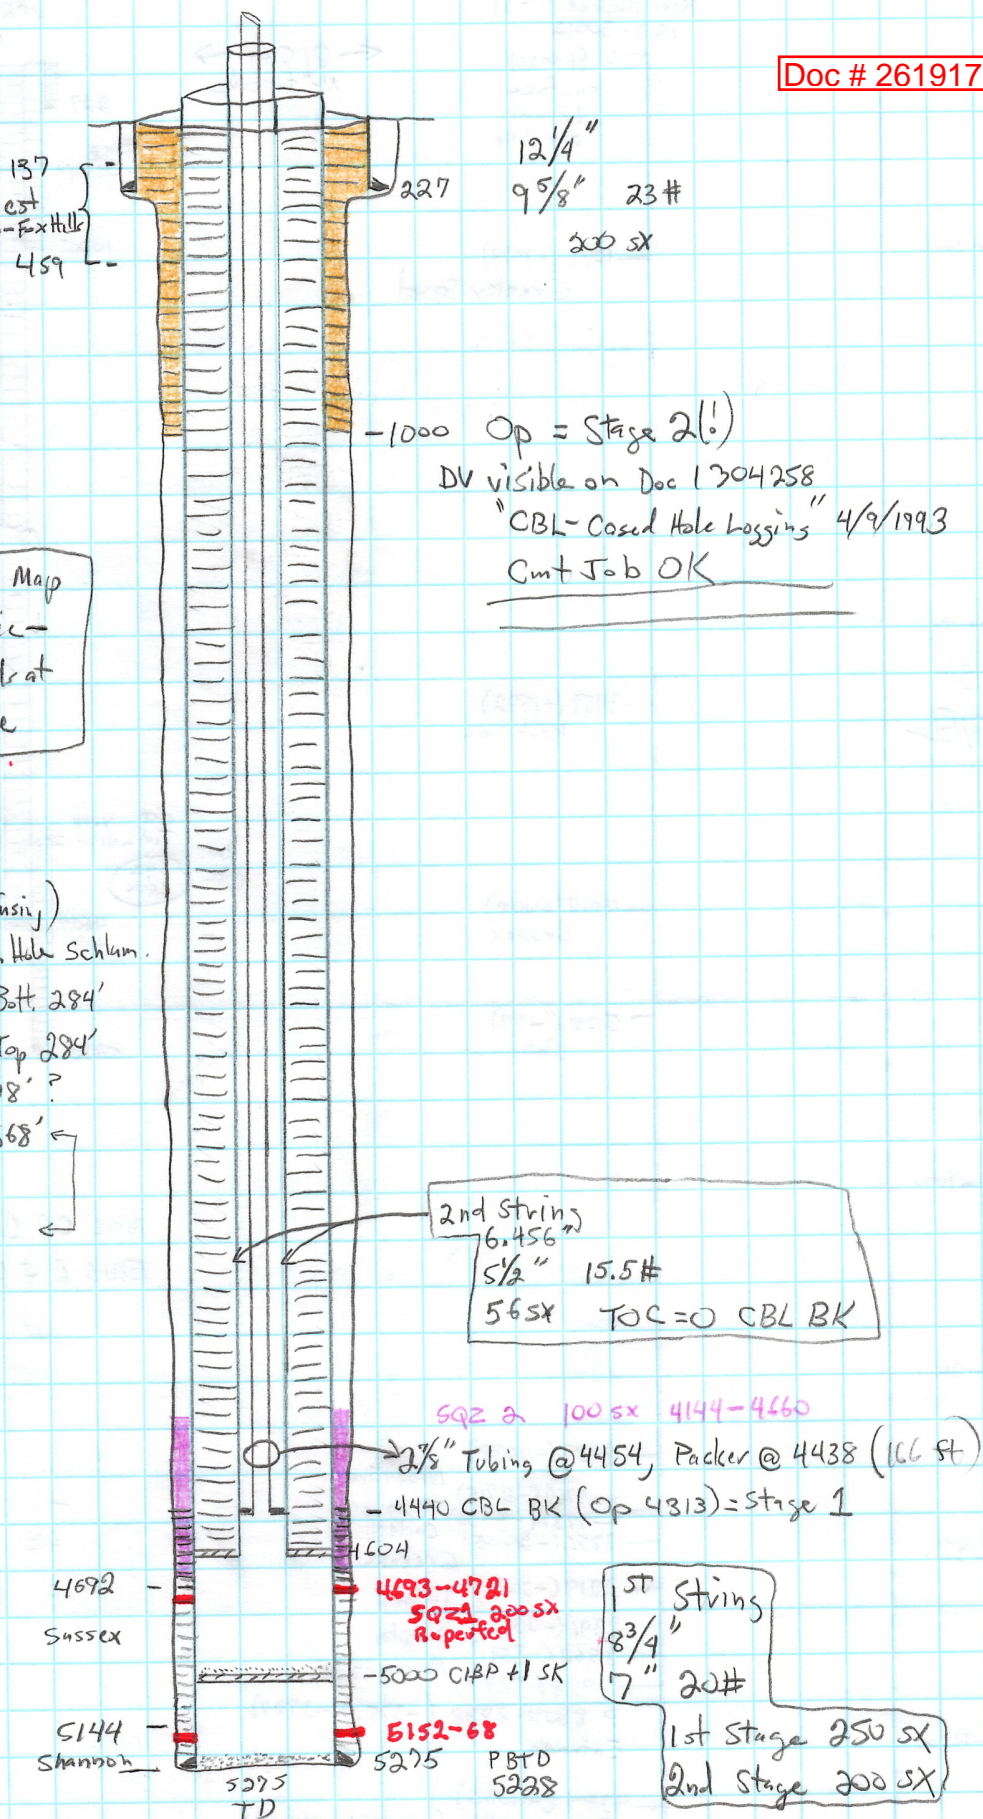

Kerr McGee 19-31
123-30012

UPRR 43 PAN AM B#1
123-07568

← 8/5 ft →
Not to scale

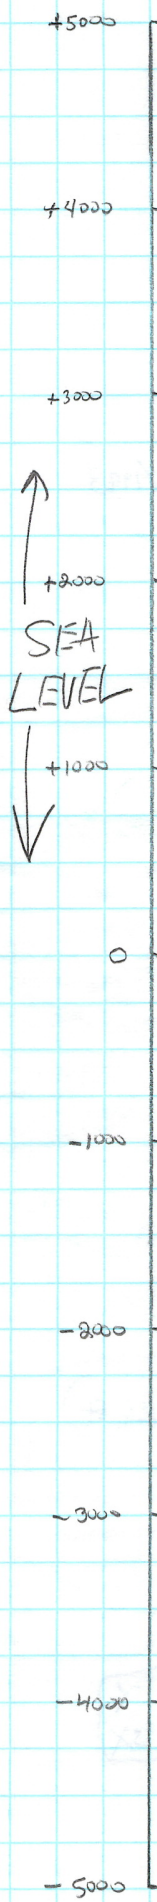

0 (+5051)
surface
Laramie
Fox Hills

1078 (+3973)
Greeley Sand

3459 (+1592)
Parkman

4553 (+498)
Sussex

5128 (-77)
Shannon

7489 (-2438)
7766 (-2715) Niobrara
7787 (-2736) Ft. Hayes
7856 (-2905) Code 11
Greenhorn

8219 (-3168) J-Sand
8391 (-3340) Dakota
8562 (-3511) Morrison
8728 (-3677)
P 8808-8838 (-3757 to -3787)
Entrada

9384 (-4333)
P 9389-9498 (-4338 to -4447)
Lyons
9715 (-4664)
P 9795-10075 (-4744 to -5024)
Fountain
10208TD (-5157)

Stage
CMT

1000'

- DV ↑ 2nd stage cmt.

1st string 7" in 8 3/4" hole

2nd string 5 1/2" in 7" casing

NO
CBL
CMT 4078
Tool - 4145
SQZ
LOGS

2 7/8 Tubing @ 4454, Parker @ 4438

4692 (+363)
P 4693-4721 (+362 to +334)
SUSSEX
← CIP @ 5000 + 1 SK 5/14/1973 ✓
5144 (-89)
P 5152-5168 (-97 to -113) Shannon
5225 (-220) TD

NGL C2 Complex ± 6.79 miles SE
EWS 6 ± 6.51 miles NE

MIT
8/8/2019
402 137 178
Cheryl Light
Randy Silver

Page 2 of 2

KOehler
5/14/2020
1/P