

# HALLIBURTON

6360 EAST YELLOWSTONE HWY • EVANSVILLE, WY 82636

TEL: 307-472-5757 • FAX: 307-232-2097

## Certified Survey Sheet

Customer: **Extraction Oil & Gas**

Well: **GP-CODY FED 20E-15-2 – Original Wellbore**

API: 05-123-50285

Legal: Sec. 20-T05N-R65W

County: Weld

State: Colorado

RKB (Patterson 901): 29'; 4,702.0' MSL

Tie-On (Koltek Surveys): 1,565.30' MD

First Sperry MWD+IFR1+MS Survey: 1,678' MD

Last Sperry MWD+IFR1+MS Survey: 14,080' MD

Straight Line Projection to TD: 14,211' MD

I certify that the attached survey is true and correct to the best of my knowledge.



02-13-2020

Kansa Becker  
Well Design Senior Technical Professional

# HALLIBURTON SPERRY DRILLING SERVICES

## CERTIFIED SURVEY WORK SHEET

<b>OPERATOR:</b>	Extraction Oil & Gas
<b>WELL:</b>	GP-CODY FED 20E-15-2
<b>FIELD:</b>	Wattenberg
<b>RIG:</b>	Patterson 901
<b>LEGALS:</b>	Sec. 20 T05N-R65W
<b>COUNTY:</b>	Weld
<b>STATE:</b>	Colorado
<b>CAL. METHOD:</b>	Minimum Curvature
<b>MAG. DECL. APPLIED:</b>	7.764
<b>VERTICAL SEC. DIR. :</b>	86.89

<b>SSDS Job Number :</b>	CA-XX-0906221583
<b>Start Date of Job :</b>	2/9/2020
<b>End Date of Job :</b>	2/11/2020
<b>Lead Directional Drillers</b>	Jonatham Davis
	Pedro Herrera
<b>Other SDS DD's :</b>	
<b>SDS MWD Engineers :</b>	Jonathan Davis
	Pedro Herrera

	Main Hole =====>		1st Side Track =====>		2nd Side Track =====>		3rd Side Track =====>		4th Side Track =====>	
	0.00	Tie On		Tie On		Tie On		Tie On		Tie On
First Surface Survey	142.30									
Last Surface Survey	1565.30									
First Intermediate Survey	1678.00	MWD								
KOP Depth	6434.00	KOP		KOP-ST1		KOP-ST2		KOP-ST3		KOP-ST4
Last Intermediate Survey	7422.00	MWD								
First Lateral Survey Depth	7516.00	MWD		MWD		MWD		MWD		MWD
Last Lateral Survey Depth	14080.00	MWD		MWD		MWD		MWD		MWD
Bit Extrapolation to TD	14211.00	T.D.		T.D.		T.D.		T.D.		T.D.

The following Halliburton Sperry Drilling Services personnel listed below, do certify the above survey information to be accurate :

Print Name : Pedro Herrera      Print Name :      Print Name :

Sign Name : *Pedro Herrera*      Sign Name :      Sign Name :

Print Name : Jonathan Davis      Print Name :      Print Name :

Sign Name : *Jonathan Davis*      Sign Name :      Sign Name :

### Examples of Survey Types:

TieOn  
MWD  
ESS  
Gyro  
SS

Tie On to Surface Casing (Assumed Vertical), Tie On to existing MWD Survey (prior drilled hole)  
Sperry Drilling Services (SDS) Measurement While Drilling (MWD) Survey's  
Sperry Drilling Services (SDS) Electronic Survey System (ESS) Survey's  
Gyro Survey's ; Provided by third party vendor, or by Sperry Drilling Services (SDS)  
Single Shot (SS) Survey's ; Provided by Sperry Drilling Services (SDS) or third party vendor.

Job# 906221583

Patterson 901

# Extraction Oil & Gas

Weld County, CO Sec. 20-T05N-R65W (GP Pad)

API# 05-123-50285

GP-CODY FED 20E-15-2

SHL: 682' FNL 1305' FEL

OWB\_50285

Design: Corrected Surveys

## Sperry Drilling Services

### Combo Report

13 February, 2020

Well Coordinates: 40.389990  
-104.682510

North American Datum 1983  
Colorado Northern Zone  
1,385,963.40 N  
3,227,709.82 E

Ground Level: 4,673.00 usft

Geodetic Scale Factor Applied

Local Coordinate Origin:

Centered on Well GP-CODY FED 20E-15-2

Viewing Datum:

KB = 29' @ 4702.00usft (Patterson 901)

TVDs to System:

N

**North Reference:**

**True**

Unit System:

Dec-Deg - API - US Survey Feet - Cust (6 dec)

Geodetic Scale Factor Applied

Version: 5000.15 Build: 91E


Report Version: Midcon Combo v1.15

**HALLIBURTON**

Project: Weld County, CO  
Site: Sec. 20-T05N-R65W (GP Pad)  
Well: GP-CODY FED 20E-15-2  
Wellbore: OWB\_50285  
Design: Corrected Surveys

# Extraction Oil & Gas Patterson 901

**HALLIBURTON**  
Sperry Drilling

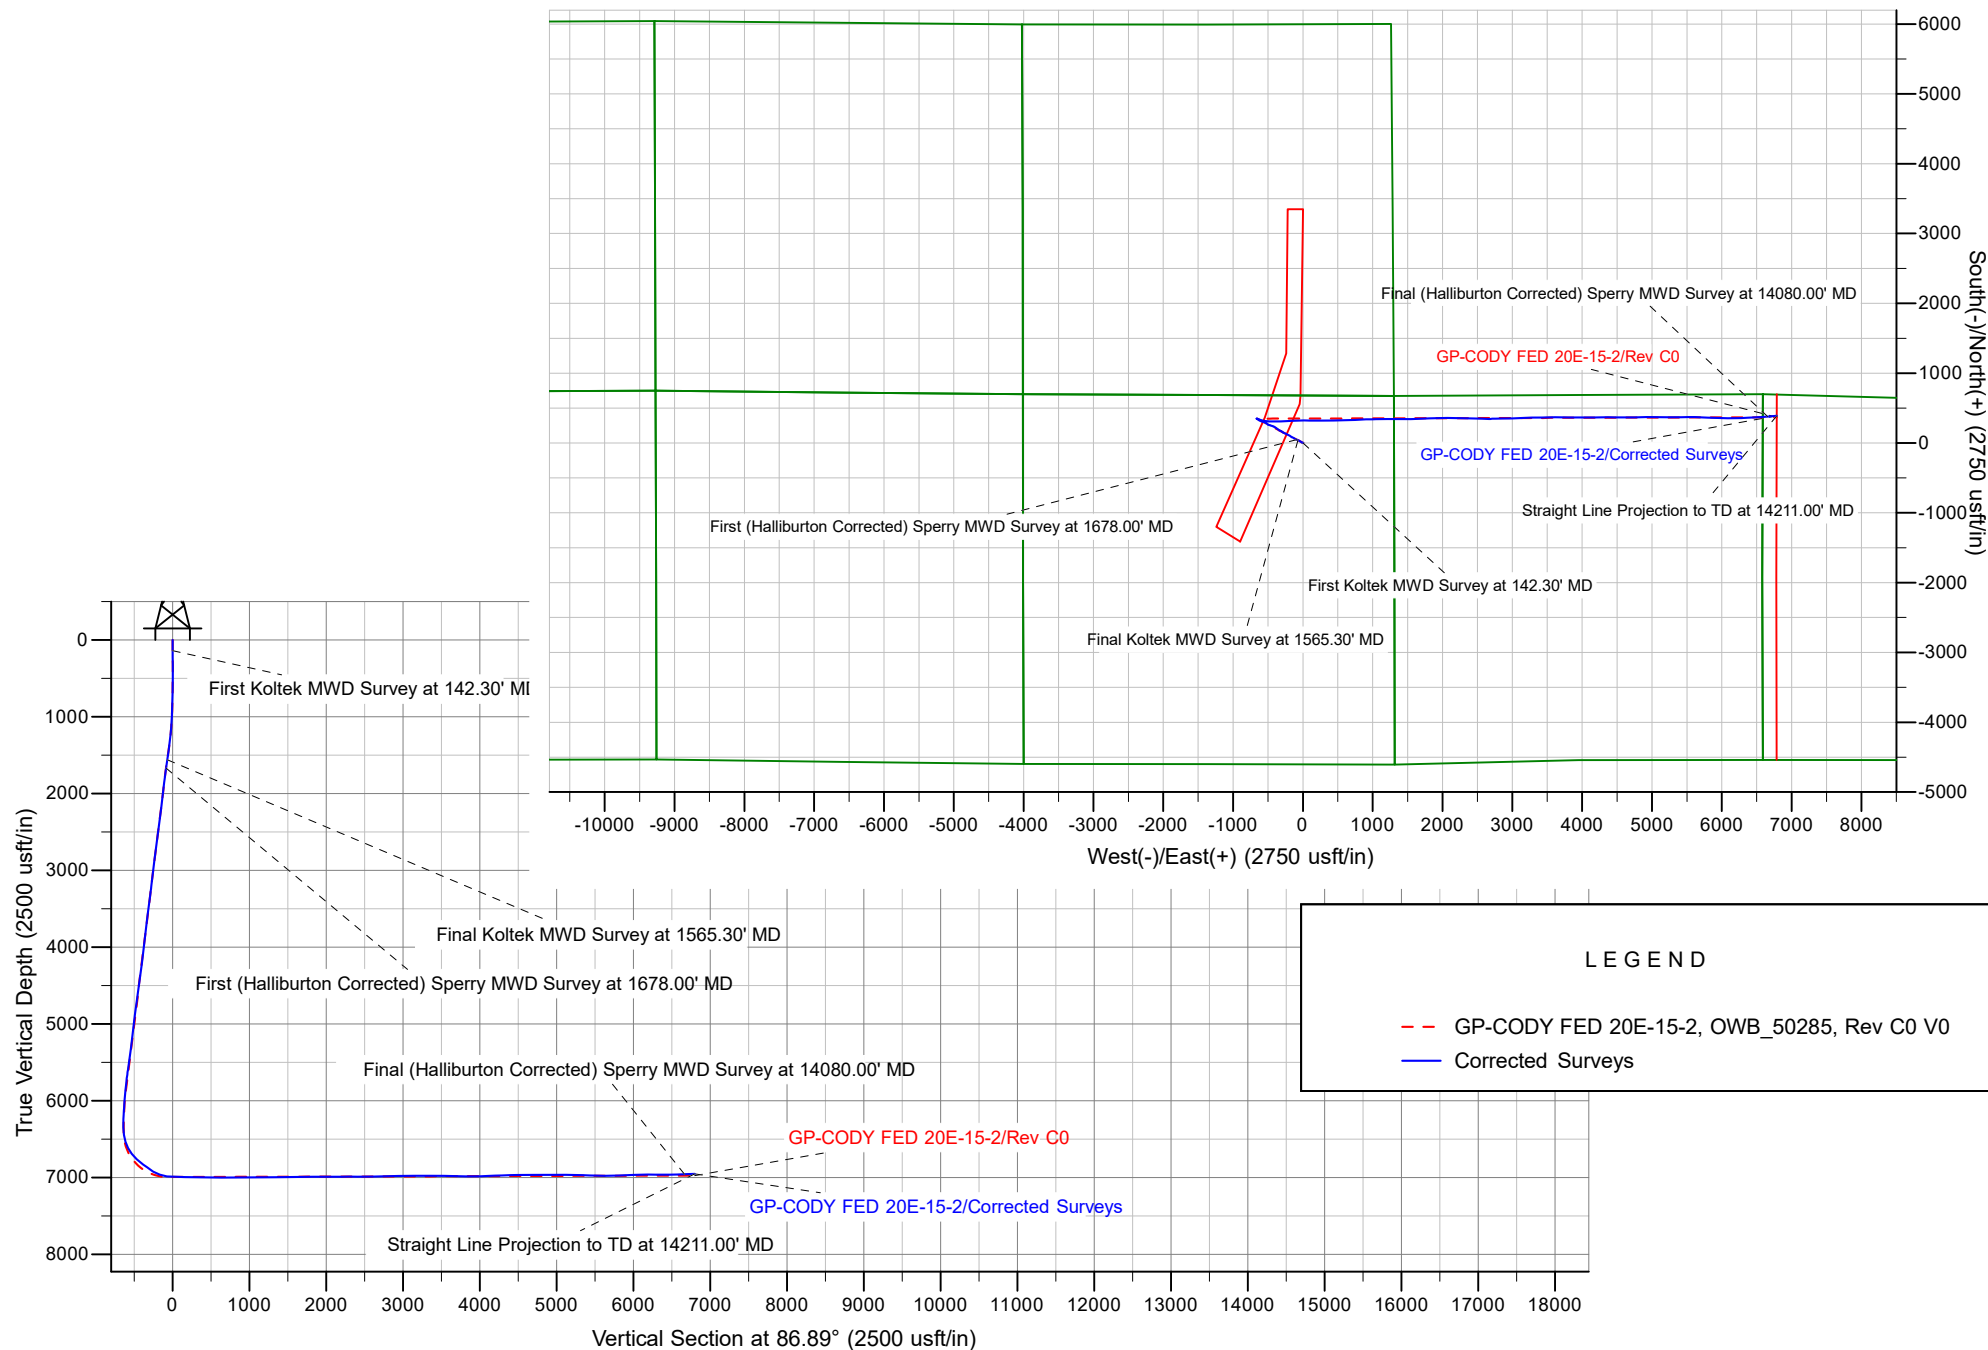

## Design Report for GP-CODY FED 20E-15-2 - Corrected Surveys

Measured Depth (usft)	Inclination (°)	True Azimuth (°)	Vertical Depth (usft)	Local Coordinates		Map Coordinates		Dogleg Rate (°/100usft)	Vertical Section (usft)	Toolface Angle (°)	Comments
				Northing (usft)	Easting (usft)	Northing (usft)	Easting (usft)				
0.00	0.00	0.00	0.00	0.00 N	0.00 E	1,385,963.40	3,227,709.82	0.00	0.00	0.00	
142.30	0.88	95.18	142.29	0.10 S	1.09 E	1,385,963.31	3,227,710.91	0.62	1.08	95.18	First Koltek MWD Survey at 142.30' MD
229.30	0.75	76.63	229.29	0.03 S	2.31 E	1,385,963.39	3,227,712.13	0.34	2.30	-125.30	
316.30	0.26	76.71	316.28	0.15 N	3.05 E	1,385,963.58	3,227,712.88	0.56	3.06	179.96	
403.30	0.13	295.21	403.28	0.24 N	3.16 E	1,385,963.67	3,227,712.98	0.43	3.16	-167.39	
491.30	0.44	287.22	491.28	0.38 N	2.74 E	1,385,963.80	3,227,712.56	0.35	2.76	-11.31	
578.30	0.97	294.95	578.27	0.79 N	1.76 E	1,385,964.20	3,227,711.57	0.62	1.80	14.05	
665.30	1.63	291.88	665.25	1.56 N	0.06 W	1,385,964.96	3,227,709.75	0.76	0.03	-7.56	
752.30	1.67	297.32	752.21	2.60 N	2.33 W	1,385,965.98	3,227,707.47	0.19	-2.19	78.40	
840.30	2.24	304.97	840.16	4.18 N	4.88 W	1,385,967.53	3,227,704.90	0.71	-4.65	28.46	
927.30	2.29	298.91	927.10	5.99 N	7.80 W	1,385,969.32	3,227,701.97	0.28	-7.46	-81.25	
1,014.30	3.03	290.38	1,014.00	7.63 N	11.47 W	1,385,970.93	3,227,698.28	0.96	-11.04	-32.45	
1,102.30	3.96	294.86	1,101.84	9.72 N	16.41 W	1,385,972.97	3,227,693.32	1.10	-15.86	18.61	
1,189.30	5.80	301.89	1,188.52	13.31 N	22.87 W	1,385,976.49	3,227,686.83	2.22	-22.11	21.53	
1,276.30	7.87	302.69	1,274.90	18.85 N	31.62 W	1,385,981.95	3,227,678.04	2.38	-30.55	3.03	
1,364.30	9.18	300.93	1,361.92	25.71 N	42.71 W	1,385,988.71	3,227,666.88	1.52	-41.25	-12.14	
1,451.30	9.10	295.65	1,447.82	32.25 N	54.86 W	1,385,995.14	3,227,654.67	0.97	-53.03	-98.05	
1,538.30	9.45	294.95	1,533.68	38.25 N	67.54 W	1,386,001.02	3,227,641.94	0.42	-65.37	-18.21	
1,565.30	9.40	293.28	1,560.32	40.05 N	71.58 W	1,386,002.79	3,227,637.88	1.03	-69.30	-101.18	Final Koltek MWD Survey at 1565.30' MD
1,678.00	8.34	293.79	1,671.67	46.99 N	87.51 W	1,386,009.57	3,227,621.89	0.94	-84.83	176.01	First (Halliburton Corrected) Sperry MWD Survey at 1678.00' MD
1,773.00	8.01	292.16	1,765.70	52.26 N	99.94 W	1,386,014.74	3,227,609.41	0.42	-96.96	-145.72	
1,868.00	9.26	302.56	1,859.63	58.87 N	112.52 W	1,386,021.23	3,227,596.77	2.10	-109.16	56.54	
1,963.00	8.81	299.94	1,953.45	66.62 N	125.26 W	1,386,028.86	3,227,583.96	0.64	-121.46	-138.85	
2,059.00	8.17	297.62	2,048.40	73.45 N	137.68 W	1,386,035.57	3,227,571.48	0.76	-133.49	-152.99	
2,154.00	7.78	296.07	2,142.48	79.40 N	149.44 W	1,386,041.42	3,227,559.67	0.47	-144.91	-151.89	
2,250.00	6.94	294.51	2,237.69	84.67 N	160.55 W	1,386,046.58	3,227,548.51	0.90	-155.72	-167.39	
2,345.00	8.95	308.26	2,331.78	91.62 N	171.58 W	1,386,053.43	3,227,537.42	2.90	-166.35	50.35	
2,440.00	7.76	304.63	2,425.77	99.85 N	182.66 W	1,386,061.55	3,227,526.26	1.37	-176.97	-157.88	
2,535.00	10.05	298.58	2,519.62	107.46 N	195.22 W	1,386,069.05	3,227,513.63	2.60	-189.10	-25.25	
2,649.00	9.23	296.54	2,632.01	116.30 N	212.13 W	1,386,077.73	3,227,496.64	0.78	-205.51	-158.39	
2,744.00	9.13	295.69	2,725.79	122.97 N	225.74 W	1,386,084.28	3,227,482.97	0.18	-218.73	-126.83	
2,839.00	8.91	295.85	2,819.62	129.45 N	239.15 W	1,386,090.63	3,227,469.50	0.23	-231.77	173.57	
2,934.00	8.02	293.34	2,913.58	135.28 N	251.86 W	1,386,096.35	3,227,456.74	1.01	-244.15	-158.69	
3,030.00	7.56	292.18	3,008.70	140.32 N	263.85 W	1,386,101.27	3,227,444.70	0.51	-255.85	-161.70	
3,125.00	6.80	291.34	3,102.95	144.72 N	274.88 W	1,386,105.58	3,227,433.63	0.81	-266.62	-172.55	
3,221.00	7.91	315.63	3,198.18	151.52 N	284.79 W	1,386,112.28	3,227,423.66	3.41	-276.15	82.68	

**Design Report for GP-CODY FED 20E-15-2 - Corrected Surveys**

Measured Depth (usft)	Inclination (°)	True Azimuth (°)	Vertical Depth (usft)	Local Coordinates		Map Coordinates		Dogleg Rate (°/100usft)	Vertical Section (usft)	Toolface Angle (°)	Comments
Northing (usft)	Easting (usft)	Northing (usft)	Easting (usft)								
3,315.00	10.03	301.38	3,291.04	160.40 N	296.31 W	1,386,121.06	3,227,412.06	3.25	-287.17	-53.53	
3,411.00	8.19	297.77	3,385.83	167.94 N	309.50 W	1,386,128.48	3,227,398.80	2.01	-299.93	-164.52	
3,505.00	7.45	291.09	3,478.95	173.26 N	321.11 W	1,386,133.68	3,227,387.15	1.25	-311.23	-132.43	
3,600.00	9.89	304.12	3,572.87	180.05 N	333.61 W	1,386,140.36	3,227,374.58	3.28	-323.35	45.40	
3,696.00	8.35	303.23	3,667.65	188.50 N	346.27 W	1,386,148.69	3,227,361.85	1.61	-335.53	-175.21	
3,791.00	8.47	304.43	3,761.63	196.23 N	357.81 W	1,386,156.32	3,227,350.24	0.22	-346.63	56.23	
3,886.00	8.43	304.93	3,855.60	204.17 N	369.29 W	1,386,164.15	3,227,338.68	0.09	-357.67	118.81	
3,982.00	8.27	305.41	3,950.58	212.20 N	380.69 W	1,386,172.08	3,227,327.21	0.18	-368.61	156.70	
4,076.00	7.82	305.80	4,043.66	219.86 N	391.38 W	1,386,179.63	3,227,316.45	0.48	-378.88	173.28	
4,172.00	7.68	296.69	4,138.78	226.56 N	402.41 W	1,386,186.23	3,227,305.36	1.29	-389.52	-101.00	
4,267.00	10.40	295.67	4,232.59	233.13 N	415.81 W	1,386,192.68	3,227,291.90	2.87	-402.55	-3.88	
4,362.00	9.03	293.72	4,326.23	239.84 N	430.37 W	1,386,199.26	3,227,277.28	1.48	-416.72	-167.45	
4,457.00	8.12	290.06	4,420.17	245.14 N	443.50 W	1,386,204.43	3,227,264.11	1.12	-429.54	-150.85	
4,553.00	7.57	289.37	4,515.27	249.57 N	455.83 W	1,386,208.74	3,227,251.73	0.58	-441.62	-170.62	
4,647.00	7.40	283.89	4,608.47	253.07 N	467.55 W	1,386,212.14	3,227,239.98	0.78	-453.13	-106.10	
4,743.00	8.74	290.24	4,703.52	257.08 N	480.39 W	1,386,216.03	3,227,227.10	1.67	-465.74	36.81	
4,837.00	8.81	283.03	4,796.42	261.18 N	494.11 W	1,386,220.00	3,227,213.35	1.17	-479.21	-89.93	
4,931.00	9.97	309.19	4,889.20	267.94 N	507.43 W	1,386,226.64	3,227,199.96	4.66	-492.15	87.96	
5,026.00	9.17	308.47	4,982.88	277.85 N	519.73 W	1,386,236.43	3,227,187.57	0.85	-503.89	-171.84	
5,121.00	7.42	311.39	5,076.88	286.62 N	530.26 W	1,386,245.10	3,227,176.96	1.89	-513.93	167.91	
5,235.00	8.71	291.30	5,189.77	294.62 N	543.83 W	1,386,252.98	3,227,163.32	2.70	-527.04	-75.58	
5,330.00	6.89	285.49	5,283.89	298.76 N	556.03 W	1,386,257.00	3,227,151.09	2.09	-539.00	-159.44	
5,426.00	8.56	288.35	5,379.02	302.54 N	568.36 W	1,386,260.68	3,227,138.72	1.78	-551.10	14.38	
5,521.00	7.45	285.28	5,473.09	306.39 N	581.01 W	1,386,264.41	3,227,126.04	1.25	-563.53	-160.45	
5,616.00	9.99	295.77	5,566.99	311.60 N	594.37 W	1,386,269.49	3,227,112.63	3.14	-576.59	37.31	
5,711.00	7.67	289.99	5,660.86	317.35 N	607.75 W	1,386,275.12	3,227,099.19	2.61	-589.64	-161.91	
5,806.00	6.32	284.01	5,755.15	320.78 N	618.79 W	1,386,278.45	3,227,088.13	1.61	-600.47	-154.60	
5,901.00	8.33	306.98	5,849.39	326.19 N	629.36 W	1,386,283.76	3,227,077.51	3.70	-610.73	67.29	
5,997.00	6.76	306.55	5,944.56	333.74 N	639.46 W	1,386,291.21	3,227,067.35	1.64	-620.40	-178.15	
6,091.00	5.14	308.39	6,038.05	339.65 N	647.20 W	1,386,297.05	3,227,059.55	1.74	-627.82	174.20	
6,186.00	3.80	302.65	6,132.76	343.99 N	653.19 W	1,386,301.34	3,227,053.52	1.49	-633.56	-164.39	
6,281.00	2.55	302.34	6,227.61	346.82 N	657.62 W	1,386,304.13	3,227,049.06	1.32	-637.84	-179.37	
6,377.00	1.73	301.60	6,323.54	348.72 N	660.66 W	1,386,306.00	3,227,046.00	0.85	-640.77	-178.44	
6,471.00	5.50	105.74	6,417.43	348.24 N	657.53 W	1,386,305.55	3,227,049.14	7.64	-637.67	167.90	
6,566.00	18.98	105.69	6,510.06	342.80 N	638.19 W	1,386,300.29	3,227,068.53	14.19	-618.64	-0.07	
6,661.00	24.43	114.88	6,598.31	330.35 N	605.46 W	1,386,288.14	3,227,101.37	6.74	-586.64	36.29	
6,757.00	35.06	100.80	6,681.64	316.77 N	560.18 W	1,386,274.98	3,227,146.77	13.18	-542.16	-39.63	

**Design Report for GP-CODY FED 20E-15-2 - Corrected Surveys**

Measured Depth (usft)	Inclination (°)	True Azimuth (°)	Vertical Depth (usft)	Local Coordinates		Map Coordinates		Dogleg Rate (°/100usft)	Vertical Section (usft)	Toolface Angle (°)	Comments
Northing (usft)	Easting (usft)	Northing (usft)	Easting (usft)								
6,851.00	49.72	94.24	6,750.91	309.02 N	497.53 W	1,386,267.80	3,227,209.49	16.27	-480.03	-19.29	
6,947.00	52.70	89.60	6,811.07	306.57 N	422.79 W	1,386,266.05	3,227,284.25	4.88	-405.53	-51.99	
7,042.00	50.76	88.66	6,869.91	307.70 N	348.21 W	1,386,267.86	3,227,358.80	2.18	-331.01	-159.46	
7,137.00	59.35	83.81	6,924.29	312.98 N	270.63 W	1,386,273.86	3,227,436.33	9.96	-253.25	-26.26	
7,232.00	71.43	89.58	6,963.81	317.73 N	184.60 W	1,386,279.41	3,227,522.31	13.86	-167.09	24.74	
7,327.00	81.87	89.27	6,985.71	318.67 N	92.30 W	1,386,281.19	3,227,614.59	10.99	-74.88	-1.69	
7,422.00	88.82	90.37	6,993.42	318.96 N	2.32 E	1,386,282.35	3,227,709.21	7.41	19.63	9.02	
7,516.00	88.76	89.80	6,995.40	318.82 N	96.30 E	1,386,283.08	3,227,803.18	0.61	113.46	-96.02	
7,611.00	88.79	90.00	6,997.44	318.99 N	191.28 E	1,386,284.12	3,227,898.15	0.21	208.31	81.47	
7,707.00	88.35	89.59	6,999.83	319.33 N	287.25 E	1,386,285.35	3,227,994.11	0.63	304.15	-137.04	
7,802.00	90.81	88.83	7,000.53	320.64 N	382.23 E	1,386,287.53	3,228,089.07	2.71	399.07	-17.17	
7,897.00	90.60	88.51	6,999.36	322.84 N	477.20 E	1,386,290.61	3,228,184.01	0.40	494.01	-123.27	
7,992.00	89.80	88.51	6,999.03	325.31 N	572.16 E	1,386,293.96	3,228,278.94	0.84	588.97	180.00	
8,087.00	90.27	88.04	6,998.97	328.17 N	667.12 E	1,386,297.69	3,228,373.86	0.70	683.94	-45.00	
8,182.00	88.92	87.44	6,999.64	331.92 N	762.04 E	1,386,302.32	3,228,468.74	1.56	778.93	-156.04	
8,277.00	88.72	86.74	7,001.60	336.74 N	856.90 E	1,386,308.01	3,228,563.55	0.77	873.91	-105.96	
8,373.00	91.18	89.85	7,001.68	339.60 N	952.84 E	1,386,311.75	3,228,659.45	4.13	969.86	51.67	
8,468.00	90.17	88.82	7,000.56	340.70 N	1,047.82 E	1,386,313.73	3,228,754.42	1.52	1,064.76	-134.43	
8,563.00	90.17	88.72	7,000.28	342.74 N	1,142.80 E	1,386,316.64	3,228,849.37	0.11	1,159.71	-90.00	
8,658.00	91.51	90.48	6,998.89	343.40 N	1,237.78 E	1,386,318.18	3,228,944.34	2.33	1,254.59	52.70	
8,752.00	90.57	90.11	6,997.18	342.92 N	1,331.76 E	1,386,318.57	3,229,038.31	1.07	1,348.41	-158.51	
8,848.00	90.77	89.64	6,996.06	343.13 N	1,427.75 E	1,386,319.66	3,229,134.30	0.53	1,444.27	-66.94	
8,943.00	90.24	89.22	6,995.22	344.07 N	1,522.75 E	1,386,321.48	3,229,229.27	0.71	1,539.17	-141.60	
9,039.00	90.77	88.66	6,994.37	345.85 N	1,618.72 E	1,386,324.14	3,229,325.23	0.80	1,635.11	-46.57	
9,133.00	90.34	88.33	6,993.46	348.32 N	1,712.69 E	1,386,327.48	3,229,419.16	0.58	1,729.06	-142.50	
9,228.00	91.01	87.73	6,992.34	351.58 N	1,807.62 E	1,386,331.62	3,229,514.06	0.95	1,824.04	-41.84	
9,323.00	89.93	87.14	6,991.57	355.83 N	1,902.52 E	1,386,336.74	3,229,608.91	1.30	1,919.03	-151.35	
9,418.00	90.44	88.91	6,991.26	359.11 N	1,997.46 E	1,386,340.89	3,229,703.81	1.94	2,014.01	73.92	
9,513.00	90.17	90.89	6,990.75	359.27 N	2,092.46 E	1,386,341.93	3,229,798.80	2.10	2,108.87	97.76	
9,608.00	90.50	91.43	6,990.20	357.35 N	2,187.43 E	1,386,340.88	3,229,893.78	0.67	2,203.60	58.57	
9,704.00	90.07	91.20	6,989.72	355.15 N	2,283.41 E	1,386,339.57	3,229,989.77	0.51	2,299.31	-151.86	
9,798.00	90.44	91.86	6,989.30	352.64 N	2,377.37 E	1,386,337.92	3,230,083.75	0.80	2,393.01	60.72	
9,893.00	90.40	91.84	6,988.61	349.57 N	2,472.32 E	1,386,335.73	3,230,178.72	0.05	2,487.65	-153.44	
9,987.00	89.90	91.08	6,988.36	347.18 N	2,566.29 E	1,386,334.20	3,230,272.70	0.97	2,581.35	-123.34	
10,083.00	89.63	90.34	6,988.75	345.99 N	2,662.28 E	1,386,333.90	3,230,368.69	0.82	2,677.13	-110.05	
10,178.00	92.22	88.74	6,987.22	346.75 N	2,757.25 E	1,386,335.54	3,230,463.65	3.20	2,772.01	-31.69	
10,273.00	92.19	88.63	6,983.56	348.93 N	2,852.16 E	1,386,338.59	3,230,558.53	0.12	2,866.89	-105.26	

**Design Report for GP-CODY FED 20E-15-2 - Corrected Surveys**

Measured Depth (usft)	Inclination (°)	True Azimuth (°)	Vertical Depth (usft)	Local Coordinates		Map Coordinates		Dogleg Rate (°/100usft)	Vertical Section (usft)	Toolface Angle (°)	Comments
				Northing (usft)	Easting (usft)	Northing (usft)	Easting (usft)				
10,369.00	92.25	88.40	6,979.85	351.41 N	2,948.05 E	1,386,341.96	3,230,654.39	0.25	2,962.78	-75.36	
10,464.00	89.87	87.93	6,978.09	354.45 N	3,042.98 E	1,386,345.88	3,230,749.29	2.55	3,057.73	-168.83	
10,559.00	90.17	88.38	6,978.05	357.51 N	3,137.93 E	1,386,349.81	3,230,844.20	0.57	3,152.71	56.31	
10,654.00	90.27	87.42	6,977.69	360.99 N	3,232.87 E	1,386,354.16	3,230,939.10	1.02	3,247.69	-84.05	
10,749.00	89.29	89.62	6,978.05	363.45 N	3,327.83 E	1,386,357.49	3,231,034.03	2.54	3,342.65	114.01	
10,843.00	89.16	88.78	6,979.33	364.76 N	3,421.81 E	1,386,359.67	3,231,127.99	0.90	3,436.56	-98.80	
10,939.00	89.26	88.63	6,980.65	366.93 N	3,517.77 E	1,386,362.73	3,231,223.93	0.19	3,532.50	-56.31	
11,034.00	88.72	87.83	6,982.32	369.86 N	3,612.71 E	1,386,366.53	3,231,318.83	1.02	3,627.46	-124.03	
11,129.00	88.45	91.86	6,984.67	370.12 N	3,707.66 E	1,386,367.67	3,231,413.77	4.25	3,722.29	93.88	
11,224.00	90.24	91.88	6,985.76	367.02 N	3,802.60 E	1,386,365.44	3,231,508.73	1.88	3,816.92	0.64	
11,319.00	89.70	90.28	6,985.81	365.23 N	3,897.58 E	1,386,364.53	3,231,603.72	1.78	3,911.66	-108.65	
11,414.00	92.02	90.46	6,984.38	364.62 N	3,992.56 E	1,386,364.79	3,231,698.70	2.45	4,006.47	4.43	
11,509.00	92.15	89.51	6,980.92	364.64 N	4,087.50 E	1,386,365.69	3,231,793.63	1.01	4,101.26	-82.19	
11,603.00	92.46	88.81	6,977.14	366.02 N	4,181.41 E	1,386,367.93	3,231,887.52	0.81	4,195.11	-66.08	
11,698.00	92.59	88.13	6,972.96	368.55 N	4,276.29 E	1,386,371.34	3,231,982.36	0.73	4,289.99	-79.15	
11,794.00	90.81	91.16	6,970.11	369.15 N	4,372.23 E	1,386,372.82	3,232,078.29	3.66	4,385.82	120.39	
11,889.00	91.71	90.99	6,968.02	367.36 N	4,467.19 E	1,386,371.91	3,232,173.26	0.96	4,480.54	-10.69	
11,985.00	88.92	90.57	6,967.49	366.06 N	4,563.17 E	1,386,371.49	3,232,269.24	2.94	4,576.31	-171.44	
12,080.00	90.44	89.80	6,968.02	365.75 N	4,658.16 E	1,386,372.06	3,232,364.23	1.79	4,671.15	-26.87	
12,175.00	90.34	89.23	6,967.38	366.55 N	4,753.16 E	1,386,373.74	3,232,459.21	0.61	4,766.04	-99.95	
12,270.00	90.47	88.45	6,966.71	368.48 N	4,848.13 E	1,386,376.54	3,232,554.16	0.83	4,860.98	-80.53	
12,366.00	91.34	87.94	6,965.19	371.50 N	4,944.07 E	1,386,380.45	3,232,650.06	1.05	4,956.95	-30.37	
12,461.00	88.62	91.36	6,965.22	372.08 N	5,039.05 E	1,386,381.90	3,232,745.02	4.60	5,051.81	128.49	
12,556.00	89.02	90.88	6,967.18	370.22 N	5,134.01 E	1,386,380.92	3,232,840.00	0.66	5,146.53	-50.19	
12,651.00	88.89	90.11	6,968.91	369.40 N	5,228.99 E	1,386,380.98	3,232,934.97	0.82	5,241.33	-99.59	
12,747.00	88.69	89.69	6,970.94	369.57 N	5,324.97 E	1,386,382.03	3,233,030.94	0.48	5,337.18	-115.47	
12,842.00	88.56	88.94	6,973.22	370.71 N	5,419.93 E	1,386,384.04	3,233,125.89	0.80	5,432.06	-99.85	
12,938.00	89.09	88.20	6,975.19	373.10 N	5,515.88 E	1,386,387.32	3,233,221.81	0.95	5,528.00	-54.39	
13,033.00	88.55	91.71	6,977.14	373.18 N	5,610.85 E	1,386,388.27	3,233,316.77	3.74	5,622.83	98.78	
13,128.00	90.20	92.76	6,978.18	369.47 N	5,705.76 E	1,386,385.44	3,233,411.71	2.06	5,717.41	32.48	
13,222.00	92.15	93.18	6,976.25	364.60 N	5,799.61 E	1,386,381.44	3,233,505.60	2.12	5,810.85	12.15	
13,318.00	92.69	92.72	6,972.20	359.67 N	5,895.40 E	1,386,377.38	3,233,601.42	0.74	5,906.23	-40.39	
13,412.00	93.36	91.94	6,967.24	355.85 N	5,989.19 E	1,386,374.43	3,233,695.24	1.09	5,999.67	-49.28	
13,507.00	90.47	89.90	6,964.06	354.33 N	6,084.11 E	1,386,373.78	3,233,790.16	3.72	6,094.37	-144.76	
13,603.00	89.66	88.74	6,963.96	355.47 N	6,180.10 E	1,386,375.81	3,233,886.14	1.47	6,190.28	-124.92	
13,699.00	89.53	88.25	6,964.63	357.99 N	6,276.06 E	1,386,379.21	3,233,982.07	0.53	6,286.24	-104.86	



## Design Report for GP-CODY FED 20E-15-2 - Corrected Surveys

Measured Depth (usft)	Inclination (°)	True Azimuth (°)	Vertical Depth (usft)	Local Coordinates		Map Coordinates		Dogleg Rate (°/100usft)	Vertical Section (usft)	Toolface Angle (°)	Comments
				Northing (usft)	Easting (usft)	Northing (usft)	Easting (usft)				
13,794.00	90.34	87.69	6,964.74	361.35 N	6,371.00 E	1,386,383.45	3,234,076.97	1.04	6,381.22	-34.66	
13,889.00	90.77	87.11	6,963.82	365.66 N	6,465.90 E	1,386,388.64	3,234,171.82	0.76	6,476.22	-53.44	
13,984.00	91.14	86.41	6,962.24	371.03 N	6,560.73 E	1,386,394.88	3,234,266.60	0.83	6,571.20	-62.13	
14,080.00	92.22	85.74	6,959.42	377.60 N	6,656.47 E	1,386,402.33	3,234,362.26	1.32	6,667.15	-31.79	Final (Halliburton Corrected) Sperry MWD Survey at 14080.00' MD
14,211.00	92.22	85.74	6,954.35	387.32 N	6,787.01 E	1,386,413.26	3,234,492.70	0.00	6,798.02	0.00	Straight Line Projection to TD at 14211.00' MD

### Design Annotations

Measured Depth (usft)	Vertical Depth (usft)	Local Coordinates		Comment
		+N/-S (usft)	+E/-W (usft)	
142.30	142.29	-0.10	1.09	First Koltek MWD Survey at 142.30' MD
1,565.30	1,560.32	40.05	-71.58	Final Koltek MWD Survey at 1565.30' MD
1,678.00	1,671.67	46.99	-87.51	First (Halliburton Corrected) Sperry MWD Survey at 1678.00' MD
14,080.00	6,959.42	377.60	6,656.47	Final (Halliburton Corrected) Sperry MWD Survey at 14080.00' MD
14,211.00	6,954.35	387.32	6,787.01	Straight Line Projection to TD at 14211.00' MD

### Vertical Section Information

Angle Type	Target	Azimuth (°)	Origin Type	Origin		Start TVD (usft)
				+N/-S (usft)	+E/-W (usft)	
Target	Cody-2_PBHL	86.89	Slot	0.00	0.00	0.00

### Survey tool program

From (usft)	To (usft)	Survey/Plan	Survey Tool
142.30	1,565.30	Koltek MWD	3_MWD+HRGM
1,678.00	14,080.00	Sperry MWD (Corrected)	3_MWD+IFR1+MS
14,211.00	14,211.00	PTB - No Survey	3_Blind

## Design Report for GP-CODY FED 20E-15-2 - Corrected Surveys

### Design Targets

Target Name	Dip	Dip							
- hit/miss target	Angle	Dir.	TVD	+N/-S	+E/-W	Northing	Easting	Latitude	Longitude
- Shape	()	()	()	()	()	()	()		
()									

### Directional Difficulty Index

Average Dogleg over Survey:	1.97 °/100usft	Maximum Dogleg over Survey:	16.27 °/100usft at 6,851.00 usft
Net Tortousity applicable to Plans:	1.17 °/100usft	Directional Difficulty Index:	6.668

### Audit Info

**North Reference Sheet for Sec. 20-T05N-R65W (GP Pad) - GP-CODY FED 20E-15-2 - OWB\_50285**

All data is in US Feet unless otherwise stated. Directions and Coordinates are relative to True North Reference.

Vertical Depths are relative to KB = 29' @ 4702.00usft (Patterson 901). Northing and Easting are relative to GP-CODY FED 20E-15-2

Coordinate System is US State Plane 1983, Colorado Northern Zone using datum North American Datum 1983, ellipsoid GRS 1980

Projection method is Lambert Conformal Conic (2 parallel)

Central Meridian is -105.500000°, Longitude Origin:0.000000°, Latitude Origin:40.783333°

False Easting: 3,000,000.00usft, False Northing: 1,000,000.00usft, Scale Reduction: 0.99995979

Grid Coordinates of Well: 1,385,963.40 usft N, 3,227,709.82 usft E

Geographical Coordinates of Well: 40.389990, -104.682510

Grid Convergence at Surface is: 0.53°

Based upon Minimum Curvature type calculations, at a Measured Depth of 14,211.00usft  
the Bottom Hole Displacement is 6,798.05usft in the Direction of 86.73° ( True).

Magnetic Convergence at surface is: -7.24° ( 9 February 2020, , BGGM2019)

