


CHAMPLIN 86 AMOCO B #3 P&A WBD

API # 05-123-08888-00

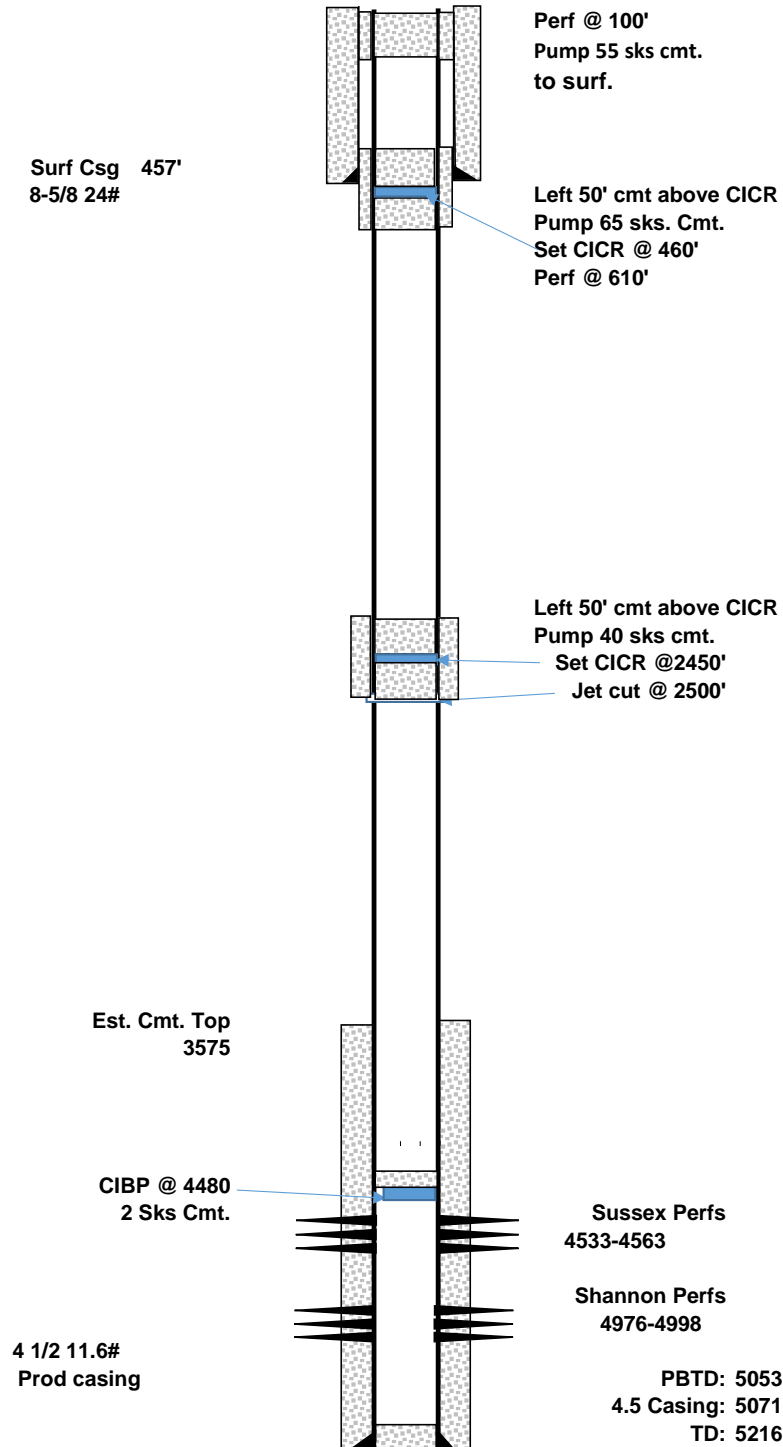

date prepared 6/1/2020