



Fee 95X

At Fee 95X, we will plum the surface casing into the flowline like is seen on the diagram below. This will maintain the pressure below the 150 psi limit as flowline pressure at Rangely field ranges from ~80-100 psi.

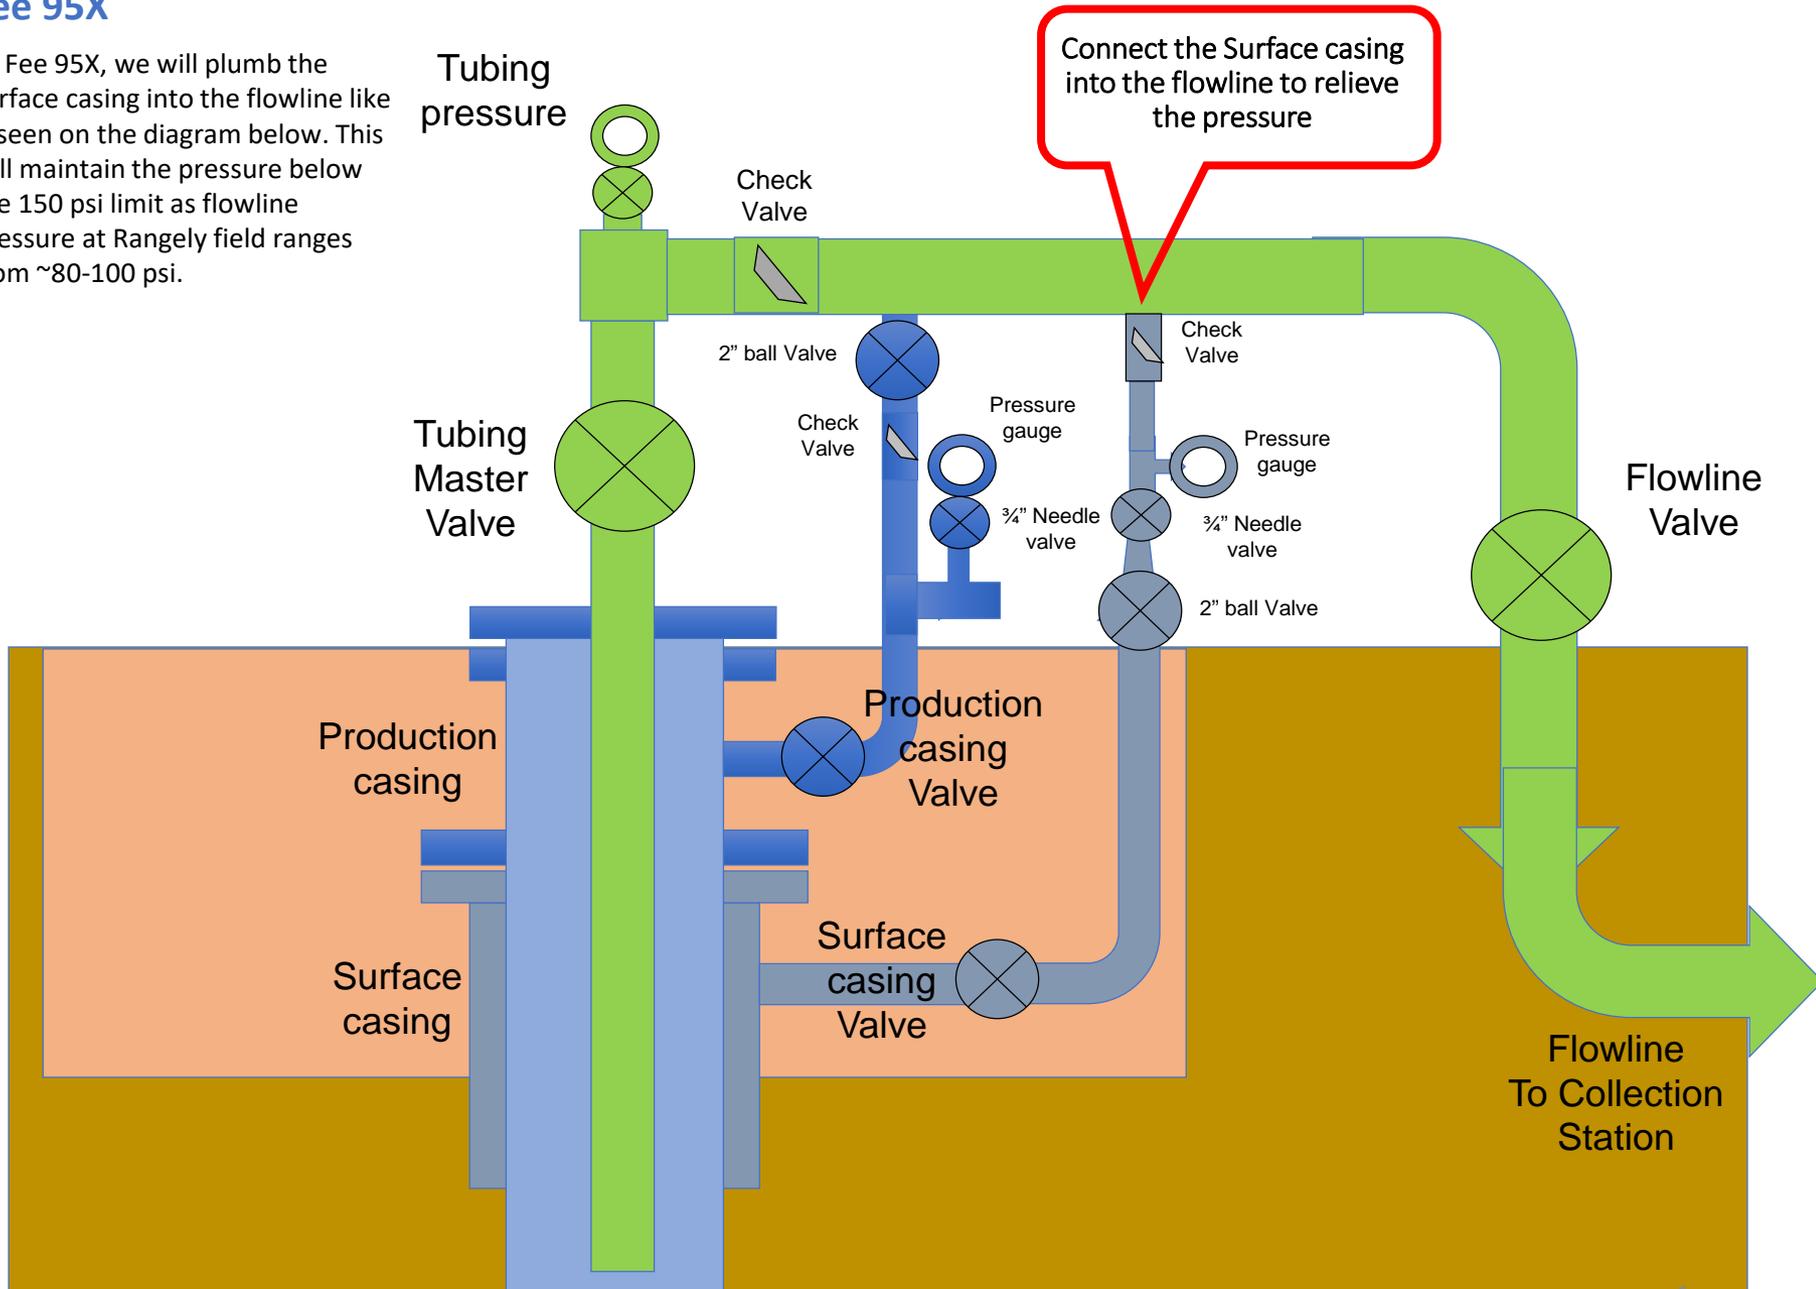

Graph of Historical Flowline Pressure at Fee 95X

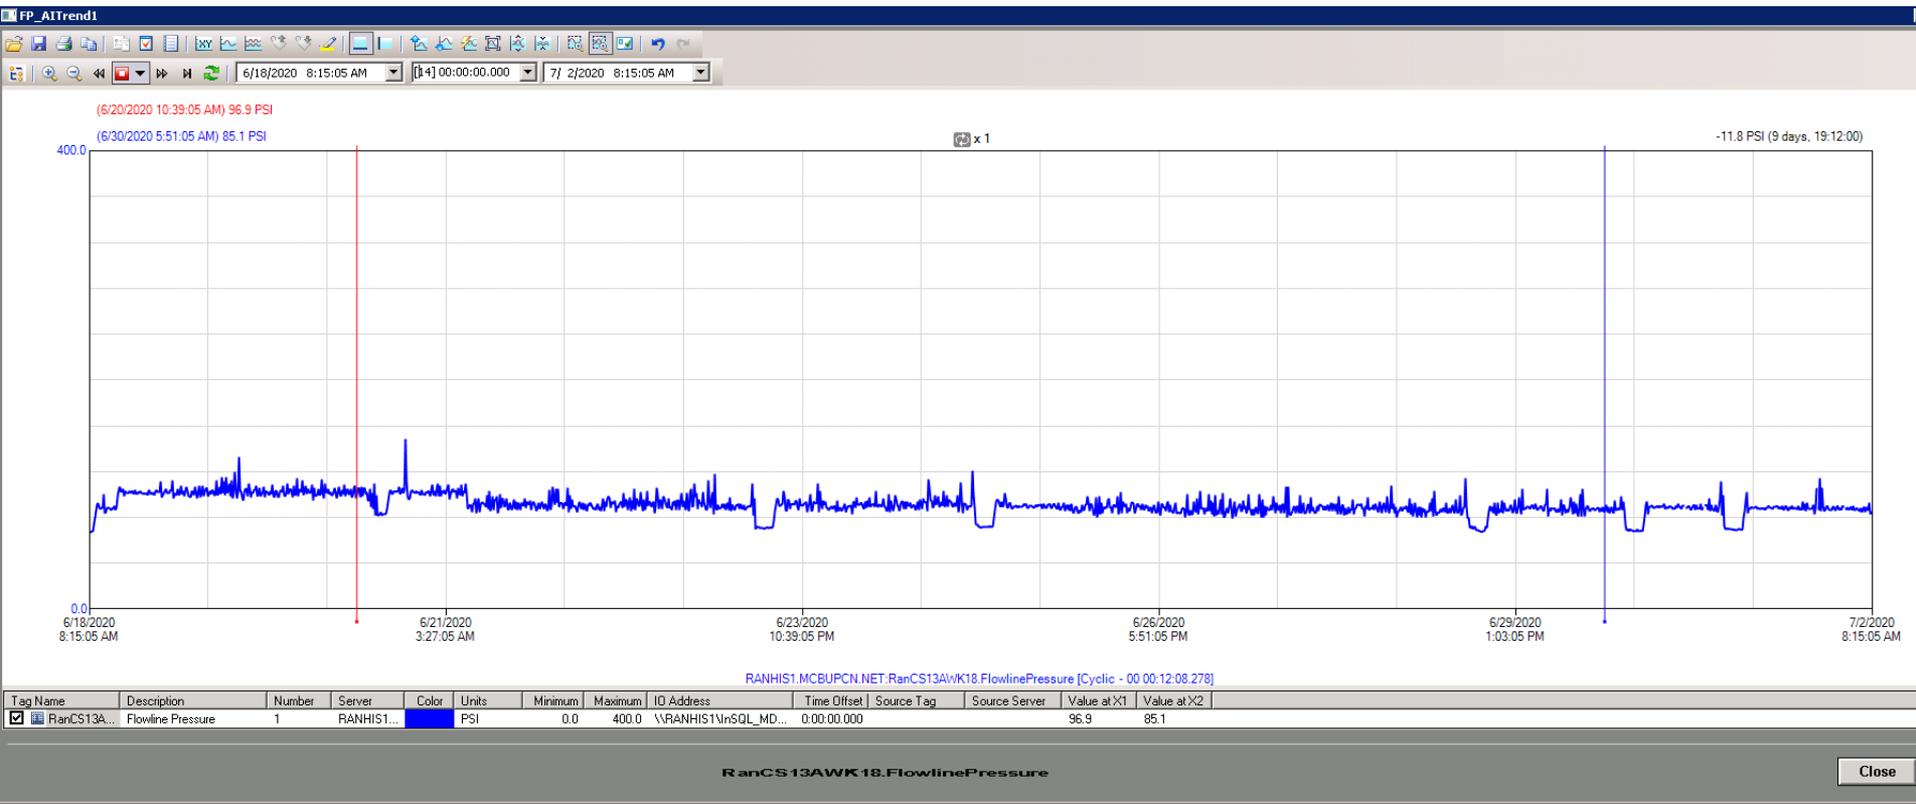

- Graph of Fee 95X flowline pressure, 6/18/20 – 7/2/20
- Consistent range of pressure from 80-100 psi