

Inspection Photos
Operator Name: EAGLE OPERATING INC
Location: 316328



Location sign and pump jack, well is producing


Inspection Photos
Operator Name: EAGLE OPERATING INC
Location: 316328



Eagle Operating remote tank battery

modified by Tom Cavanaugh
July 9, 2020 for eForm 44

Inspection Photos
Operator Name: EAGLE OPERATING INC
Location: 316328

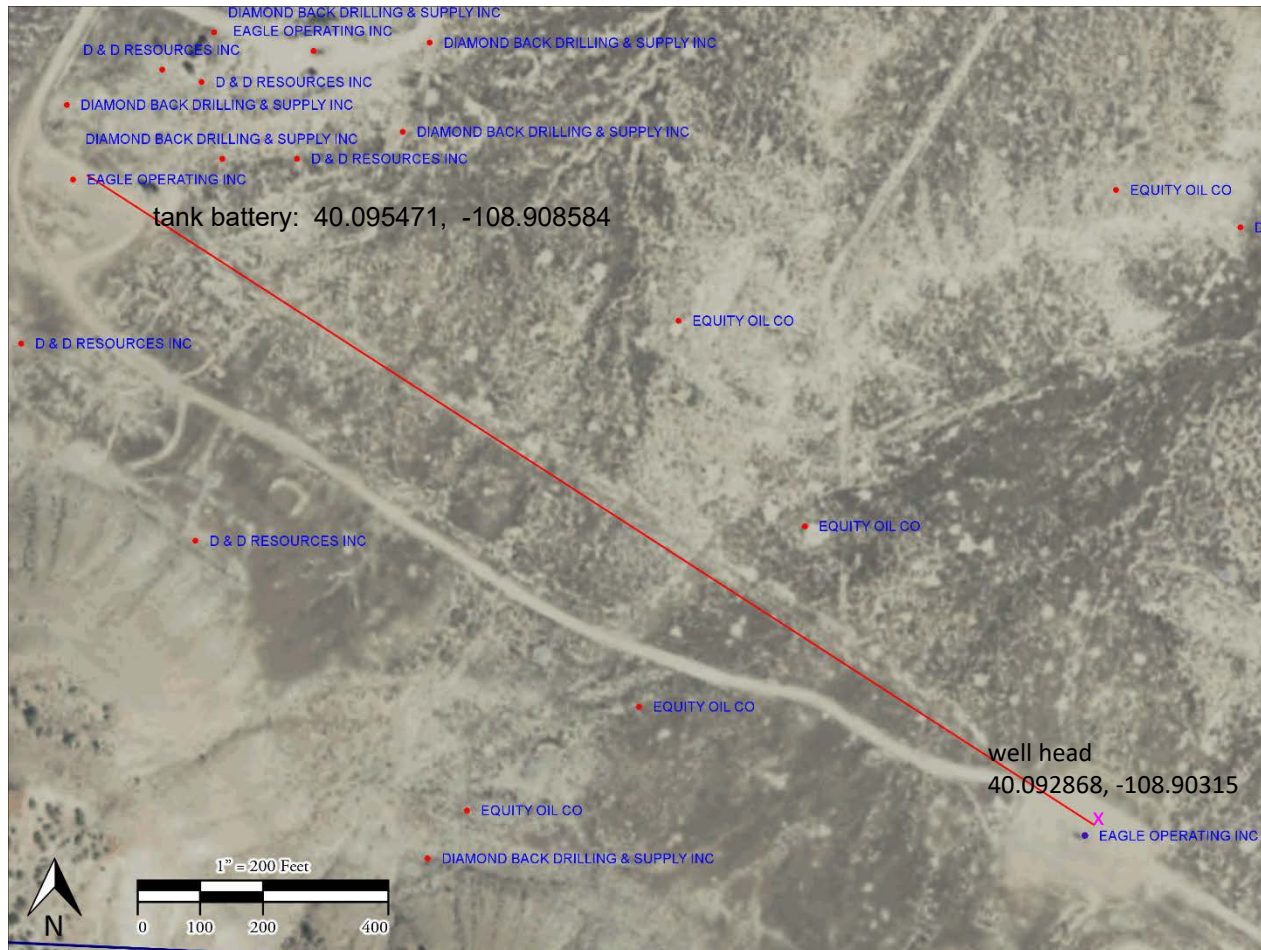

**Eagle Operating location and remote
tank battery. 1888' from wellhead to
tank battery**