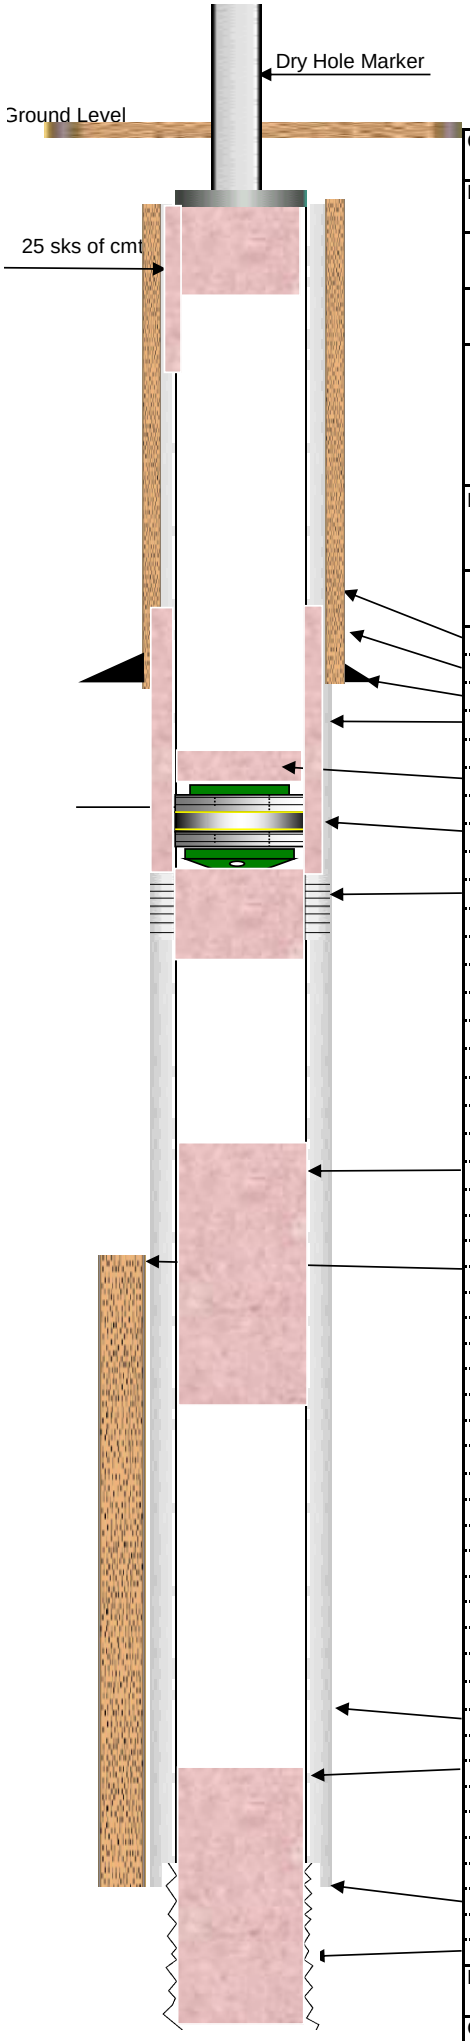

COMPANY Public Service Company Of Colorado				**DATE** 7/14/2020	
LEASE Asbury Storage Unit-Fed #4. API# 05-077-05093					
Surface Casing 8-5/8"	**Weight** 24#	**Grade** J-55	**Thread** LT&C	**Depth** 539'	
Prod Casing 4-1/2"	**Weight** 9.5#	**Grade** J-55	**Thread** LT&C	**Depth** 2777'	
Tubing String	**Size** 2 3/8	**Weight** 4.7#	**Grade** J-55	**Thread** 8rd EUE	**Depth** 2678'
Second String	**Size**	**Weight**	**Grade**	**Thread**	**Depth**
Prepared for:	**Perforations:** Dakota Open hole Section 2772' to 2810'				

ITEM No#	Length	Description	ID	OD	Depth
1		375 sks of surface cement from 539' - 0			
2		12-1/4" surface hole	12.25		
3		8-5/8" Surface Casing @ 539'.	7.972	8.625	539.00
4		50 Sks of Cement Squeezed thru CICR			
		Top of cement @ 234' CBL on 7/1/2020			
5		1 bbls of cement on top of CICR.			
6		CICR @ 489'			489.00
7		Squeeze holes @589'			589.00
		10 Sack Cement casing plug from			
		1775' to 1675'.			
		Top of cement @ 1726'			
		CBL Dated 6/29/2020			
		Hole size 6-3/4" drilled in October 1965	6.75		
		75 sks G Neat Cement 2540' to 2811'			
		Pull tagged on 6/29/2020			
		Plug in open hole and casing.			
		4-1/2" Casing landed @ 2777'.	3.965	4.5	
		Open Hole Section 2777' to 2811'			2811.00

PREPARED BY Jeff Schneider		**PHONE:** 970-381-9588	
OFFICE Fort Morgan, CO	**PHONE** 970-867-9437	**INVOICE #**	