


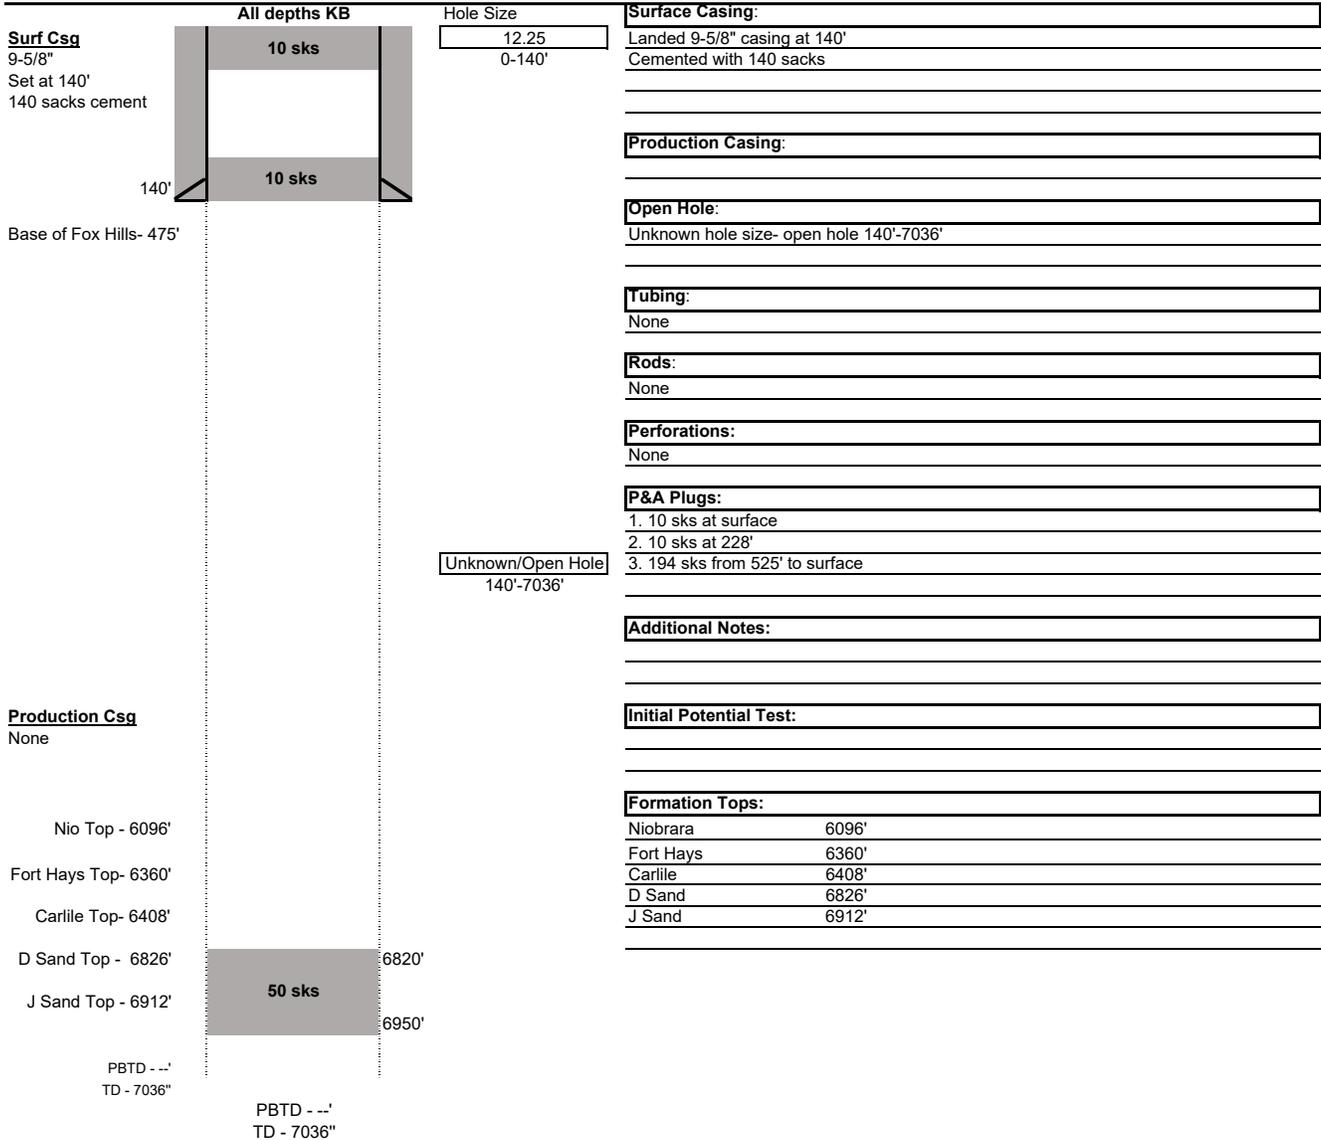

Current Wellbore Schematic

Well Name: Brungard 1
 Location: 1980' FNL, 1980' FEL, SWNE Sec 23, T8N, R60W
 County: Weld
 API #: 05-123-05542
 Co-ordinates: 40.649636, -104.055958 (As Surveyed)
 Elevations: GROUND: UNKNOWN
 KB: _____
 Depths (KB): PBTD: --
TD: 7036'

Date Prepared: 3/21/2019
 Last Updated: 7/21/2020
 Spud Date: 3/19/1956
 Completion Start Date: N/A
 Last Workover Date: N/A
 Prepared by: Ariana Solis





Current Wellbore Schematic

Well Name: Brungard 1
 Location: 1980' FNL, 1980' FEL, SWNE Sec 23, T8N, R60W
 County: Weld
 API #: 05-123-05542
 Co-ordinates: 40.649636, -104.055958 (As Surveyed)
 Elevations: GROUND: UNKNOWN
 KB: _____
 Depths (KB): PBTD: --
TD: 7036'

Date Prepared: 3/21/2019
 Last Updated: 7/21/2020
 Spud Date: 3/19/1956
 Completion Start Date: 3/31/1956
 Last Workover Date: N/A
 Prepared by: Matt Ostertag

