


Well Name: MILLAGE C12-19

VERTICAL, ORIGINAL HOLE, 7/29/2020 4:36:17 PM

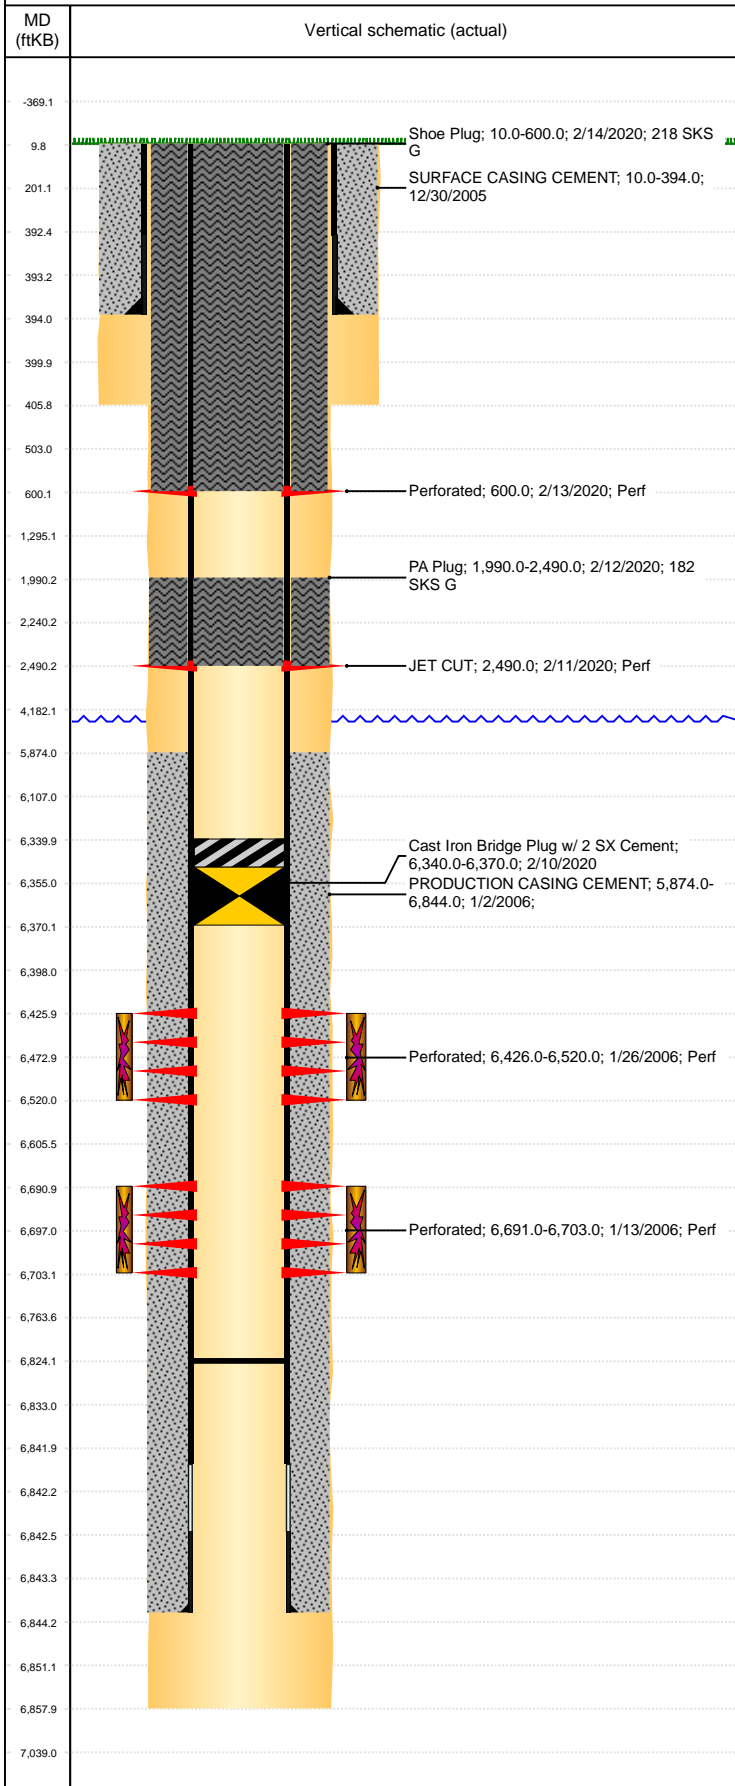

Well Header									
API 05-123-23453			Business Unit DJ BASIN			District 15		Well Config VERTICAL	
KB - GL / MSL (ft... 10.00		Spud Date 12/30/2005		P & A Date 4/1/2020		Well Production Status PA			SoRT Yes
Comment									
Surface Location (Congressional)									
Qtr 3 SW	Qtr 4 NW	Section 12	Twonshp 4	Twonsh... N	Range 64	Rng E/... W	Actual Latitude (°) 40.33030824	Actual Longitude (°) -104.50360808	
Wellbore Sections									
Section Des			Size (in)			Act Top, MD (ftKB)		Act Btm, MD (ftKB)	
SURFACE			12 1/4			10		406	
PRODUCTION			7 7/8			406		6,858	
Casing Strings									
Csg Des			Run Date		OD (in)	Wt/Len (lb/ft)	Grade	Top, MD (ftKB)	MD (ftKB)
Surface			12/30/2005		8 5/8	24.00		10.0	394.0
Production			1/2/2006		4 1/2	11.60	M-80	10.0	6,844.0
Cement									
Des					Start Date		Top (ftKB)		Btm (ftKB)
SURFACE CASING CEMENT					12/30/2005		10.0		394.0
PRODUCTION CASING CEMENT					1/2/2006		5,874.0		6,844.0
PA Plug					2/12/2020		1,990.0		2,490.0
Shoe Plug					2/14/2020		10.0		600.0
Zone Statuses									
Zone Name		Status Date	Status	Fluid Type	Job			Prod Method	
CODELL		1/30/2006	PR		DRILLING/COMPLETION - ORIGINAL, 12/30/200...			Flowing	
CODELL		2/10/2020	P&A		PLUG AND ABANDON, 2/8/2020 00:00				
NIOBRARA		1/30/2006	PR		DRILLING/COMPLETION - ORIGINAL, 12/30/200...			Flowing	
NIOBRARA		2/10/2020	P&A		PLUG AND ABANDON, 2/8/2020 00:00				
Perforation Data									
Linked Zone			Bnch/Stg	Entered Shot Total	Top (ftKB)		Btm (ftKB)		Date
NIOBRARA, ORIGINAL HOLE CODELL, ORIGINAL HOLE				6	600.00		600.00		2/13/2020
					2,490.00		2,490.00		2/11/2020
				180	6,426.00		6,520.00		1/26/2006
				48	6,691.00		6,703.00		1/13/2006
Stimulation Intervals									
Zone					Start Date		Top (ftKB)		Btm (ftKB)
NIOBRARA, ORIGINAL HOLE					1/26/2006		6,426.0		6,520.0
CODELL, ORIGINAL HOLE					1/26/2006		6,691.0		6,703.0
Other In Hole									
Run Date		Des			Make		OD (in)	Top (ftKB)	Btm (ftKB)
2/10/2020		Cast Iron Bridge Plug w/ 2 SX Cement					4	6,340.0	6,370.0
Logs									
Date		Type					Top, MD (ftKB)		Btm, MD (ftKB)
1/2/2006		COMPENSATED DENSITY					3,450.0		6,829.0
1/2/2006		INDUCTION					394.0		6,849.0
1/13/2006		CEMENT BOND					5,751.0		6,804.0
Plug Back Total Depths									
Date		Type			Com				Depth (ftKB)
1/13/2006		FILL			DEPTH LOGGER ON CBL				6,806.0
4/3/2006		FILL			CLEANOUT TO 6824'				6,824.0