




RECEIVED
JAN 21 1963

R.66 W

OIL & GAS
CONSERVATION COMMISSION

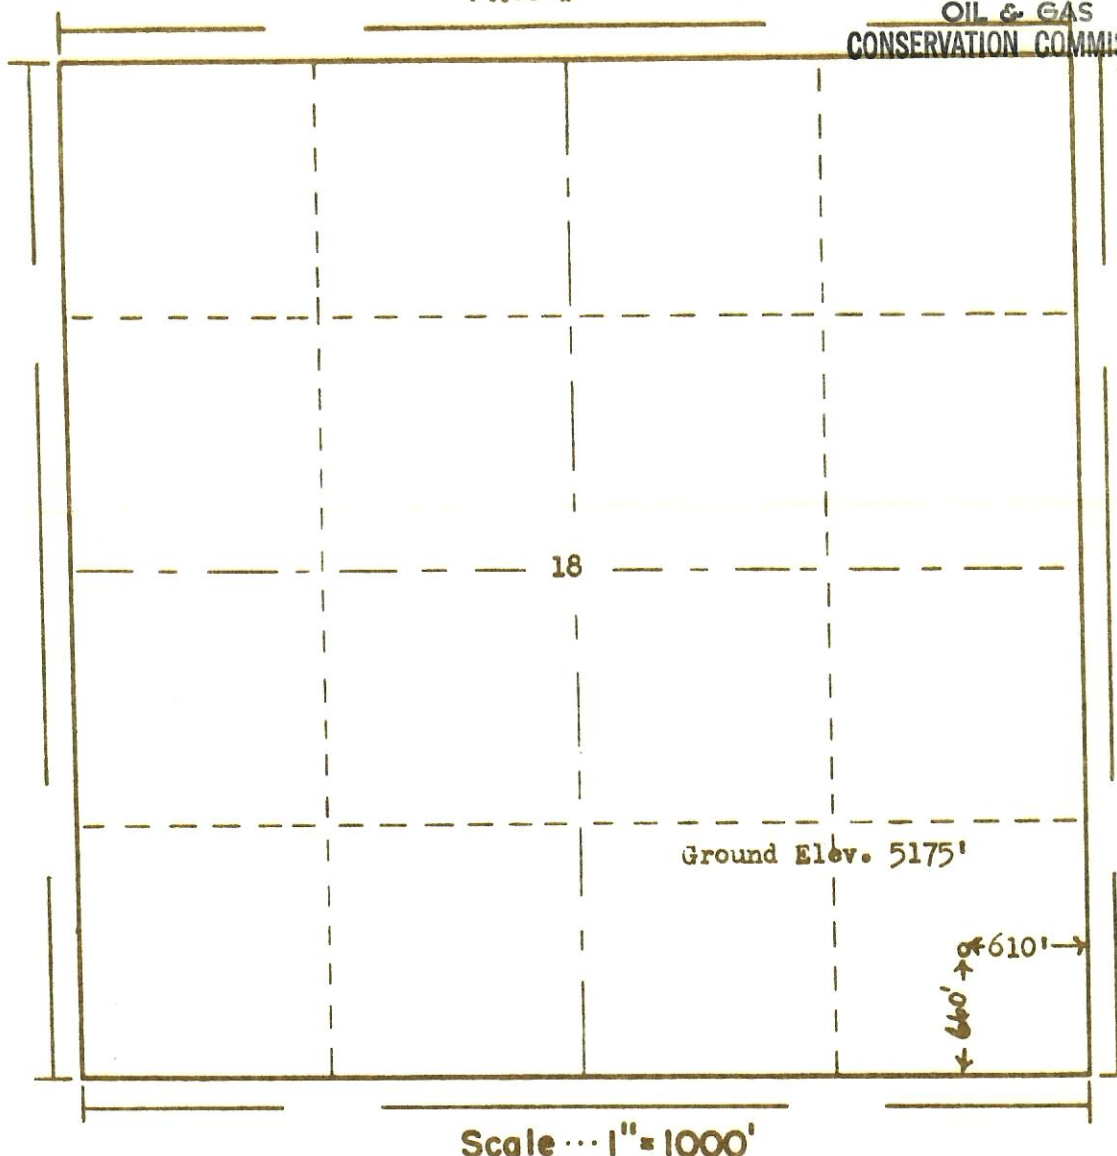

Powers Elevation Company of Denver, Colorado
has in accordance with a request from John Chandler
for UNITED PRODUCING Co., Inc. determined the
Location of No. 1 H.A. Boyd
to be 610' FE & 660' FS Section 18 Township 8 North
Range 66 West of the 6th Principal Meridian
Weld County, Colorado

The above Plat shows the location of the well site
in said section.

Powers Elevation Company

by: *Beryl L. Holloway*

Date: 1-16-63

Registered Land Surveyor No. 2853 State of Colorado