



Schematic - Selected

Well Name: AD FED DOUBLE CLUTCH 20W-25-08


API 0512345035	Surface Legal Location NWSW S21 T5N R65W M6	Field Name WATTENBERG	License # 401049089	State/Province COLORADO	Well Configuration Type HORIZONTAL
Original KB Elevation (ft) 4,667.00	KB-Tubing Head Distance (ft)	Spud Date Production 1/30/2020 14:30	Rig Release Date 2/2/2020 04:30	PBTD (All) (ftKB)	Total Depth All (TVD) (ftKB) Original Hole - 6,871.0

Most Recent Job

Job Category COMPLETION	Primary Job Type INITIAL COMPLETION	Secondary Job Type	Start Date 3/24/2020	End Date 7/1/2020
----------------------------	--	--------------------	-------------------------	----------------------

TD: 19,515.0

HORIZONTAL, Original Hole, 8/3/2020 3:20:16 PM

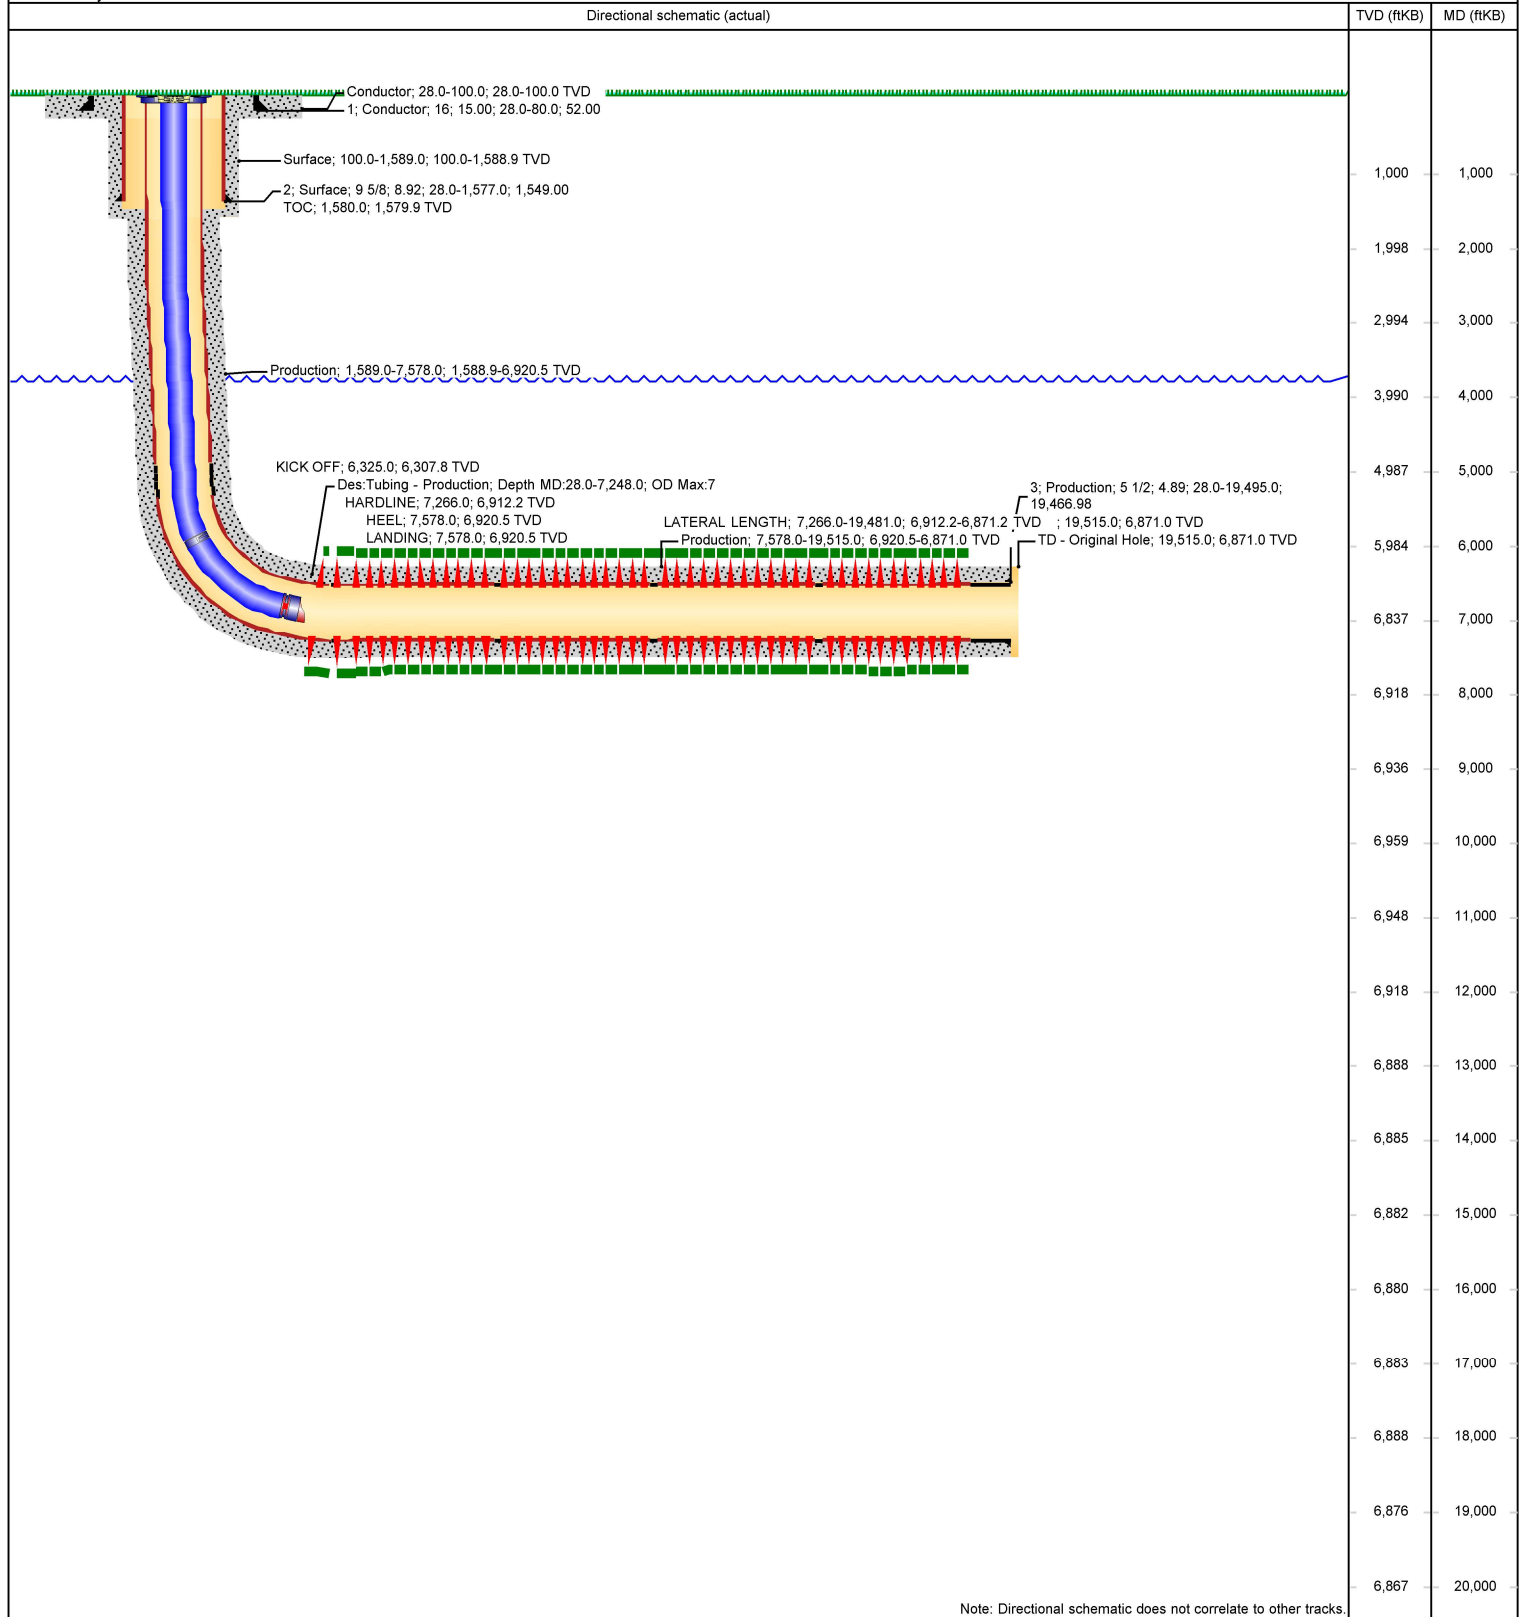

Note: Directional schematic does not correlate to other tracks.