

CERTIFICATE OF SURVEY  
for  
Rex Monahan  
Logan County, Colorado




00238404

RECEIVED

JUL 26 1978

COLO. OIL & GAS CONS. COMM.

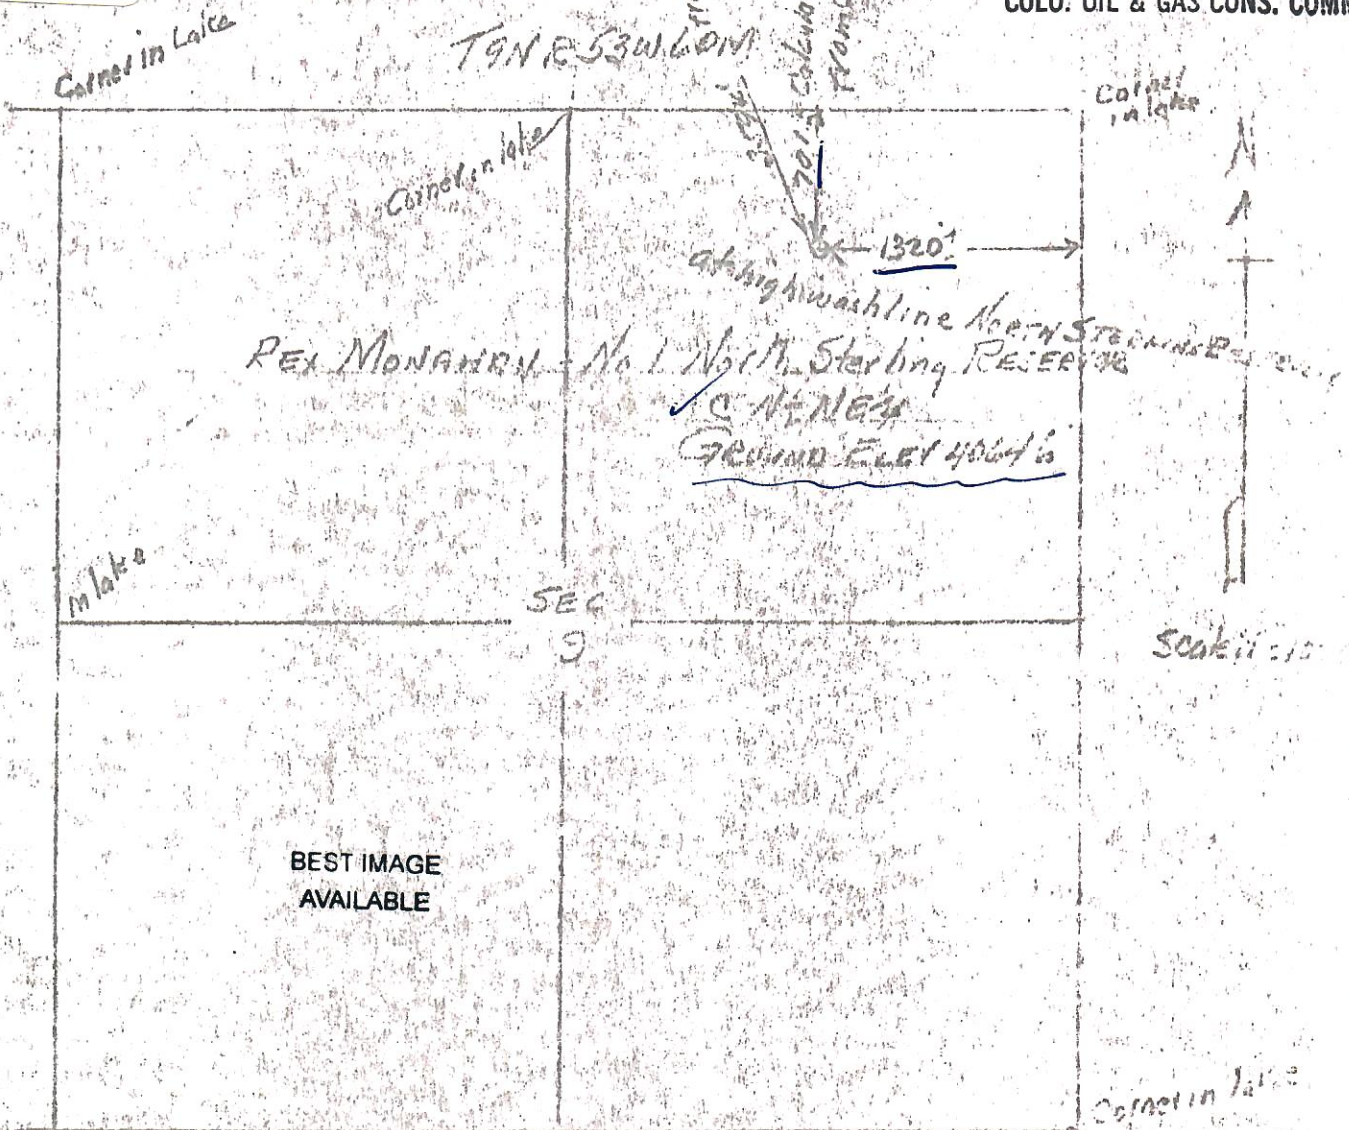

I hereby certify that the above plat is an accurate representation of a correct survey showing the location of Rex Monahan No. 1 North Sterling Reservoir Oilwell in N. 1/4 Sec. 9 T9N R53W 6PM. The elevation of the ground at the stake is 4064.6 feet above sea level from U.S.G.S. Bench Mark.

Fort Morgan, Colorado  
July 14, 1978

*Harold J. Osborne*  
Registered Professional Engineer  
State of Colorado

*Blair J. [unclear]  
[unclear]  
[unclear]*