



CORRECTED COPY

OIL AND GAS CONSERVATION COMMISSION OF THE STATE OF COLORADO

FEB 13 1963

NOTICE OF INTENTION TO DRILL

OIL & GAS
CONSERVATION COMMISSION

INSTRUCTIONS:

A notice of intention to drill a well shall be filed in duplicate on all Federal and Patented lands, and in triplicate on all State lands. Do not begin operations until approved copy has been received. It is mandatory that the proposed location comply with all rules and regulations of the Commission. Locate well on section grid in proper location, and indicate extent of lease. Unless operations are commenced within 180 days after the date of approval hereof, this approval to drill will become null and void.

Name of Operator KARL SCHMIDT and THOMAS PRODUCING COMPANY Phone No. TA 2-8351 & TA 4-4591
Address Petroleum Center City San Antonio State Texas

How is liability secured: Well Bond (Attached) ☐; Blanket Bond ☐; Waiver ☒
(Check one)


*Well to be drilled under Lewmont Drilling Associates, Inc., bond.

Lease Name Montague

Well No. 1

Field Name Wildcat ☒

County Logan

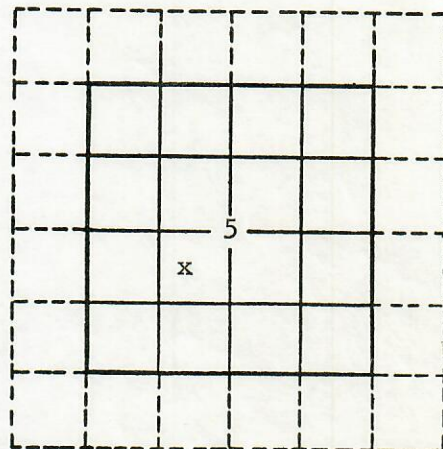

Location NE SW Section 5 Township 9 N Range 53 W Meridian 6th P.M.
(quarter quarter)
1842 feet from S Section line and 1923 feet from W Section Line
N or S E or W

The well is located on: Patented land ☒ State land ☐ Federal land ☐

The well is located within a spaced area: Yes ☐ No ☒

Distance from proposed location to nearest property or lease line 717 feet.

Distance from proposed location to nearest drilling unit line --- feet.

Objectives: "D" Sand Depth 4850'; "O" Sand Depth 5250'
Formation Estimate Formation Estimate

Proposed length of surface casing 100 feet.

REMARKS:

Location was moved to avoid the Sterling Reservoir. Verbal approval for moving obtained from Wm. R. Smith 2-9-63.

Agcn.	<u>Attached</u>
Spot	<u>Plotted 2-13-63</u>
600 ft.	<u>Under OK</u>
1200 ft.	
Wells	
Oil	
Gas	
Status	

I/We hereby swear (or affirm) that the statements herein made are a full and correct report.

APPROVED:

FEB 13 1963

Date _____

J. Rogers
Deputy Director

Company Lewmont Drilling Associates, Inc. Date February 11, 1963

Address 1700 Broadway
Denver 2, Colorado

By L.W. Bay Phone No. TA 5-0253
Signature Title Petroleum Engineer