



FORM F-106




02357052

R. 53W

RECEIVED

MAR 7 1972

COLO. OIL & GAS COM. COMM.

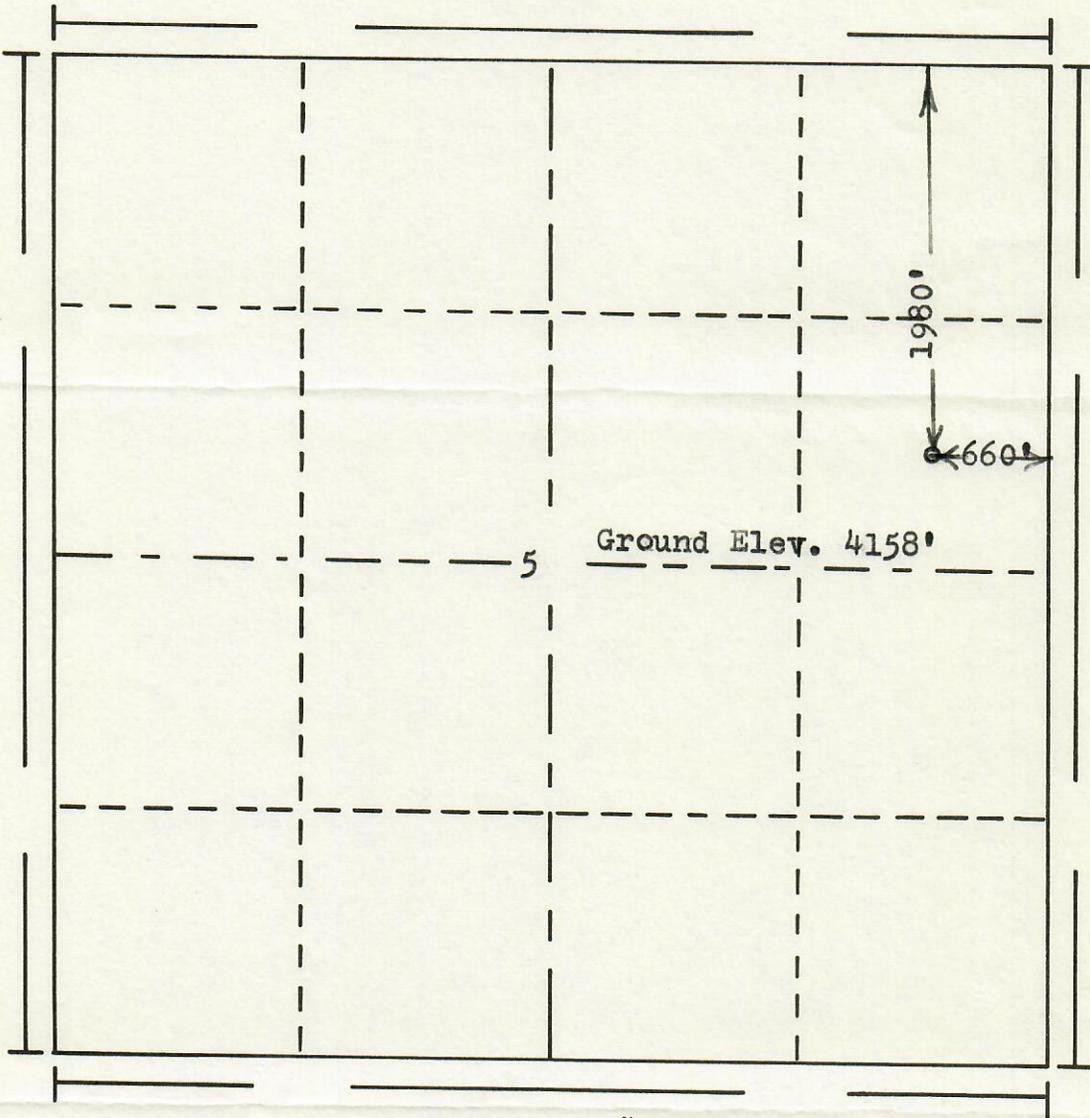

T. 9 N

Scale... 1" = 1000'

Powers Elevation Company, Inc. of Denver, Colorado
 has in accordance with a request from Michelle
 for Sage Oil Co. & Exeter Drlg. & Exploration Co.
 determined the location of No. ? ?
 to be CSE NE Section 5 Township 9N
 Range 53W of the 6th Principal Meridian
 Logan County, Colorado

I hereby certify that this plat is an
 accurate representation of a correct
 survey showing the location of

Date: 2-25-72

Ray S. Hollaway

Licensed Land Surveyor No. 2853
 State of Colorado

