


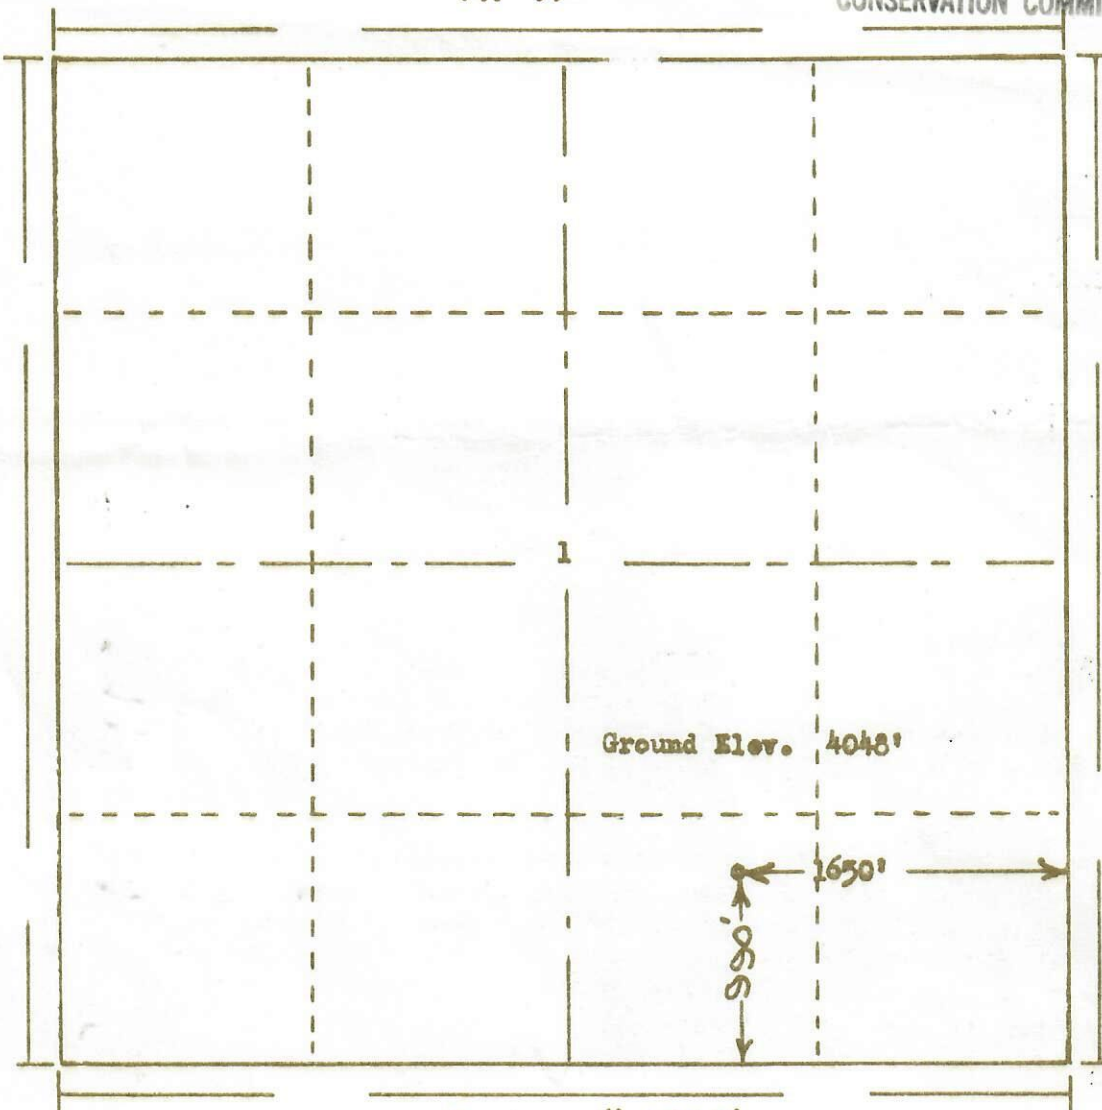

00818010

RECEIVED
APR 21 1966OIL & GAS
CONSERVATION COMMISSION

R. 53W

T.
9
N

Ground Elev. 4048'

1650'

990'

Scale ... 1" = 1000'

Powers Surveyors, Inc. of Denver, Colorado
has in accordance with a request from Mr. Chancellor
for Sterling Oil Co. determined the
Location of No. 1 Parke
to be 990' RS & 1650' RE Section 1 Township 9N
Range 53W of the 6th Principal Meridian
Logan County, Colorado

66 133

I hereby certify that this plat is an
accurate representation of a correct
survey showing the location of

Date: 4-14-66

Billy G. Hollman
Licensed Land Surveyor No. 12853
State of Colorado