

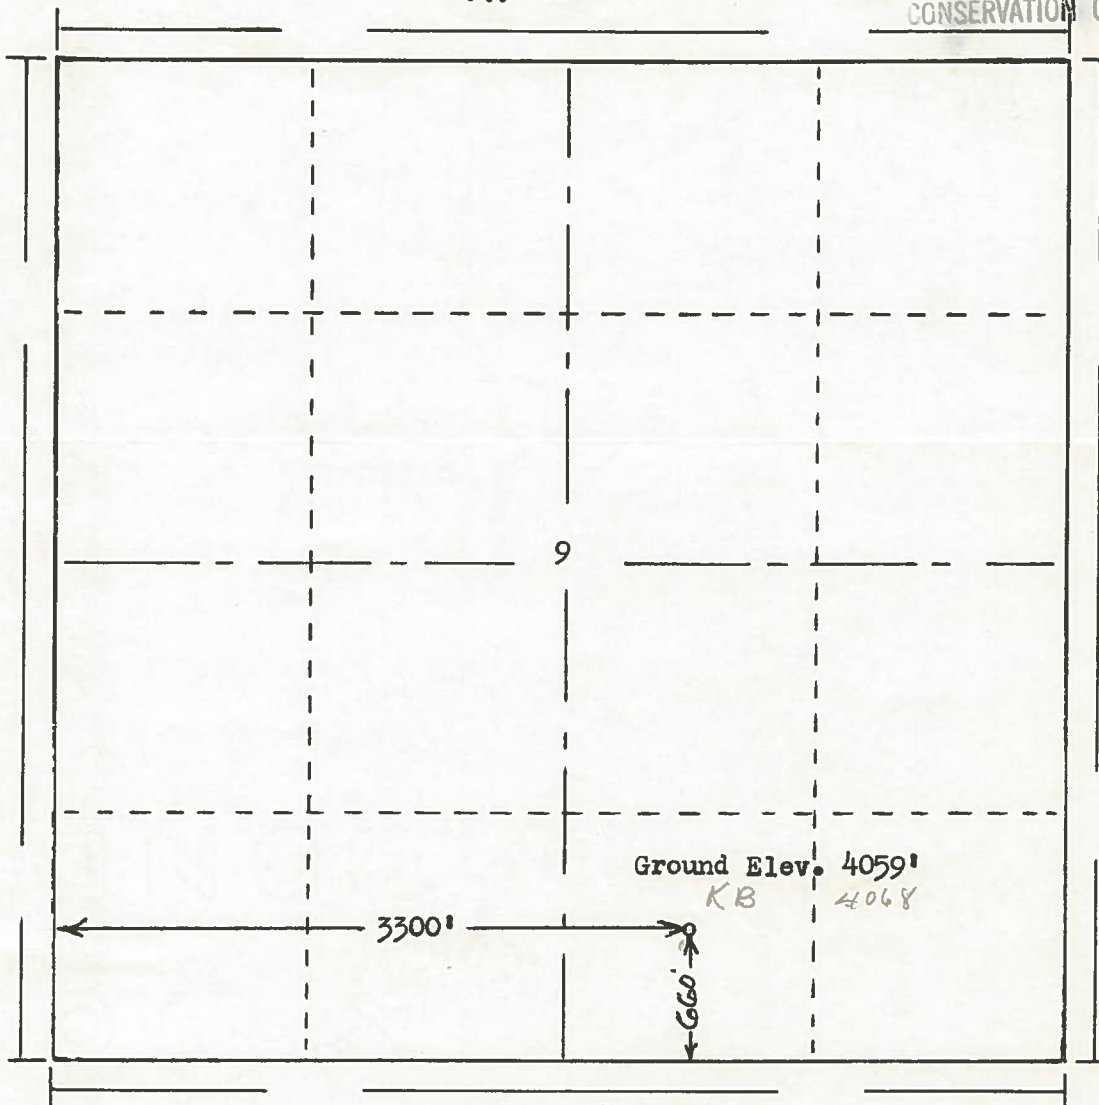


00817939

JAN 20 1965

OIL & GAS
CONSERVATION COMMISSION

R. 53W

T.
9
N

Scale ... 1" = 1000'

Powers Surveyors, Inc. of Denver, Colorado
has in accordance with a request from Mr. Umbach
for Paul Umbach determined the
Location of No. 2 Whitaker
to be CSW SE Section 9 Township 9N
Range 53W of the 6th Principal Meridian
Logan County, Colorado

I hereby certify that this plat is an
accurate representation of a correct
survey showing the location of

1-14-65

Billy G. Holloway
Licensed Land Surveyor No. 2853
State of Colorado