



00819128

Interoffice OGCC-1
Rev. 7/8/55


VERBAL REQUESTS

NOTICE OF INTENTION TO DRILL ✓

Bonding Status _____

NOTICE OF INTENTION TO ABANDON _____

OTHER _____

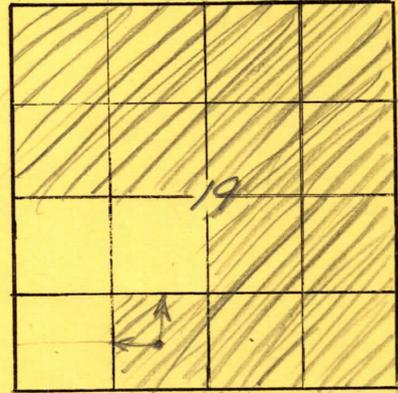

55W

COMPANY U.S.S.R.#M.

BY Getrock

ADDRESS 900 Patterson Bldg - Denver

Title _____

LEASE Henderson

WELL NUMBER 9-55 #1-19

COUNTY Logan

FIELD W.C.

LOCATION - By Quarters SESW Sec. 19 Twp. 9N R. 55W Mer. 6th

The Well is located 661 ft. (N) of Section Line, and 1933 ft. (E) of Section line.

DETAILS OF PLAN OF WORK: T.D. 6000' FORMATION Test #1

ESTIMATED DATE OF WORK: _____ ESTIMATED TIME: _____

APPROVED BY: DWR

DATE 4-17-58

AD	
DVR	
WRS	
HMM	
JAM	
FJP	
JJD	
FILE	

