




00272330

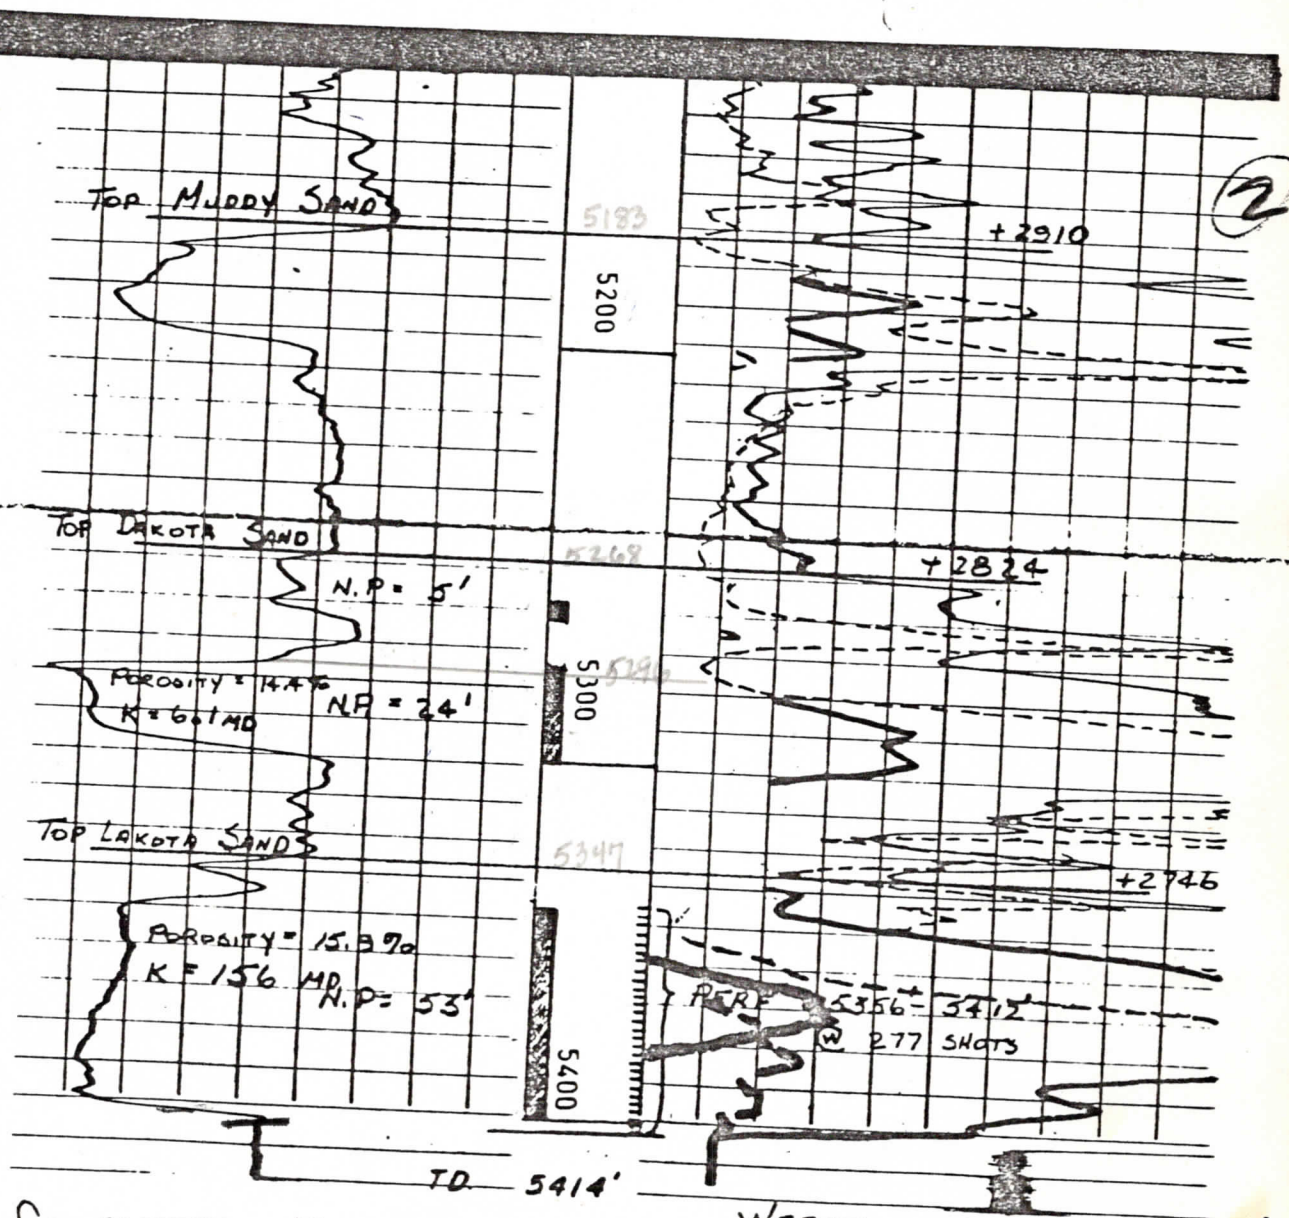

COMPLETED 12-23-44
FOR IFP 181 BOPD
10,745 MCF CO₂

WEBSTER No. 1.
NW NW SEC 18-9N-70W
JACKSON COUNTY, COLORADO
KB = 8093' GR = 8083'

Unit #6